


CLAIM OF BENEFICIAL USE MAP
NW 1/4 Section 1, T.27S. R.17E., W.M.
Lake County, Oregon

Larry and Tara Grassman
T-8764

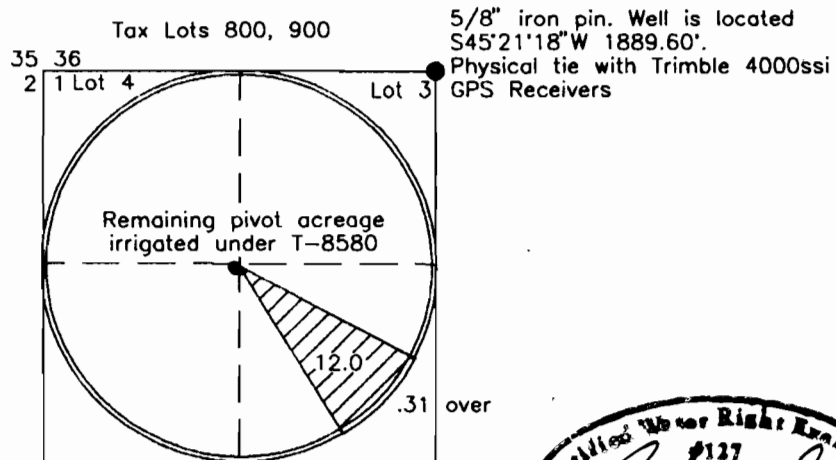

Prepared by: Sundet & Associates
P.O. Box 1228
Lakeview, OR 97630
(541)947-3293

 12 acres transferred from
Permit G-10159 Cert. 80796

This map is for the purpose of identifying the location
of the water right only and is not intended to provide
legal dimensions or location of property ownership lines.