

RECEIVED BY OWRD


APR 29 2013

SALEM, OR

T-9582


- ⊗ C-2229 1879-50² 1884-72⁵
- ⊗ C-50363 1879-72²⁵
- ⊗ C-75966 1880-36²³ 1896 81²⁵
- ⊗ C-75967 1885-12² 1886-1⁴
- ⊗ C-75968 1880-9²
- ⊗ C-79536 1915-99⁶

- Infiltration Gallery
POD 1, 2, 3, 4, 5 & 7
- Pump Station

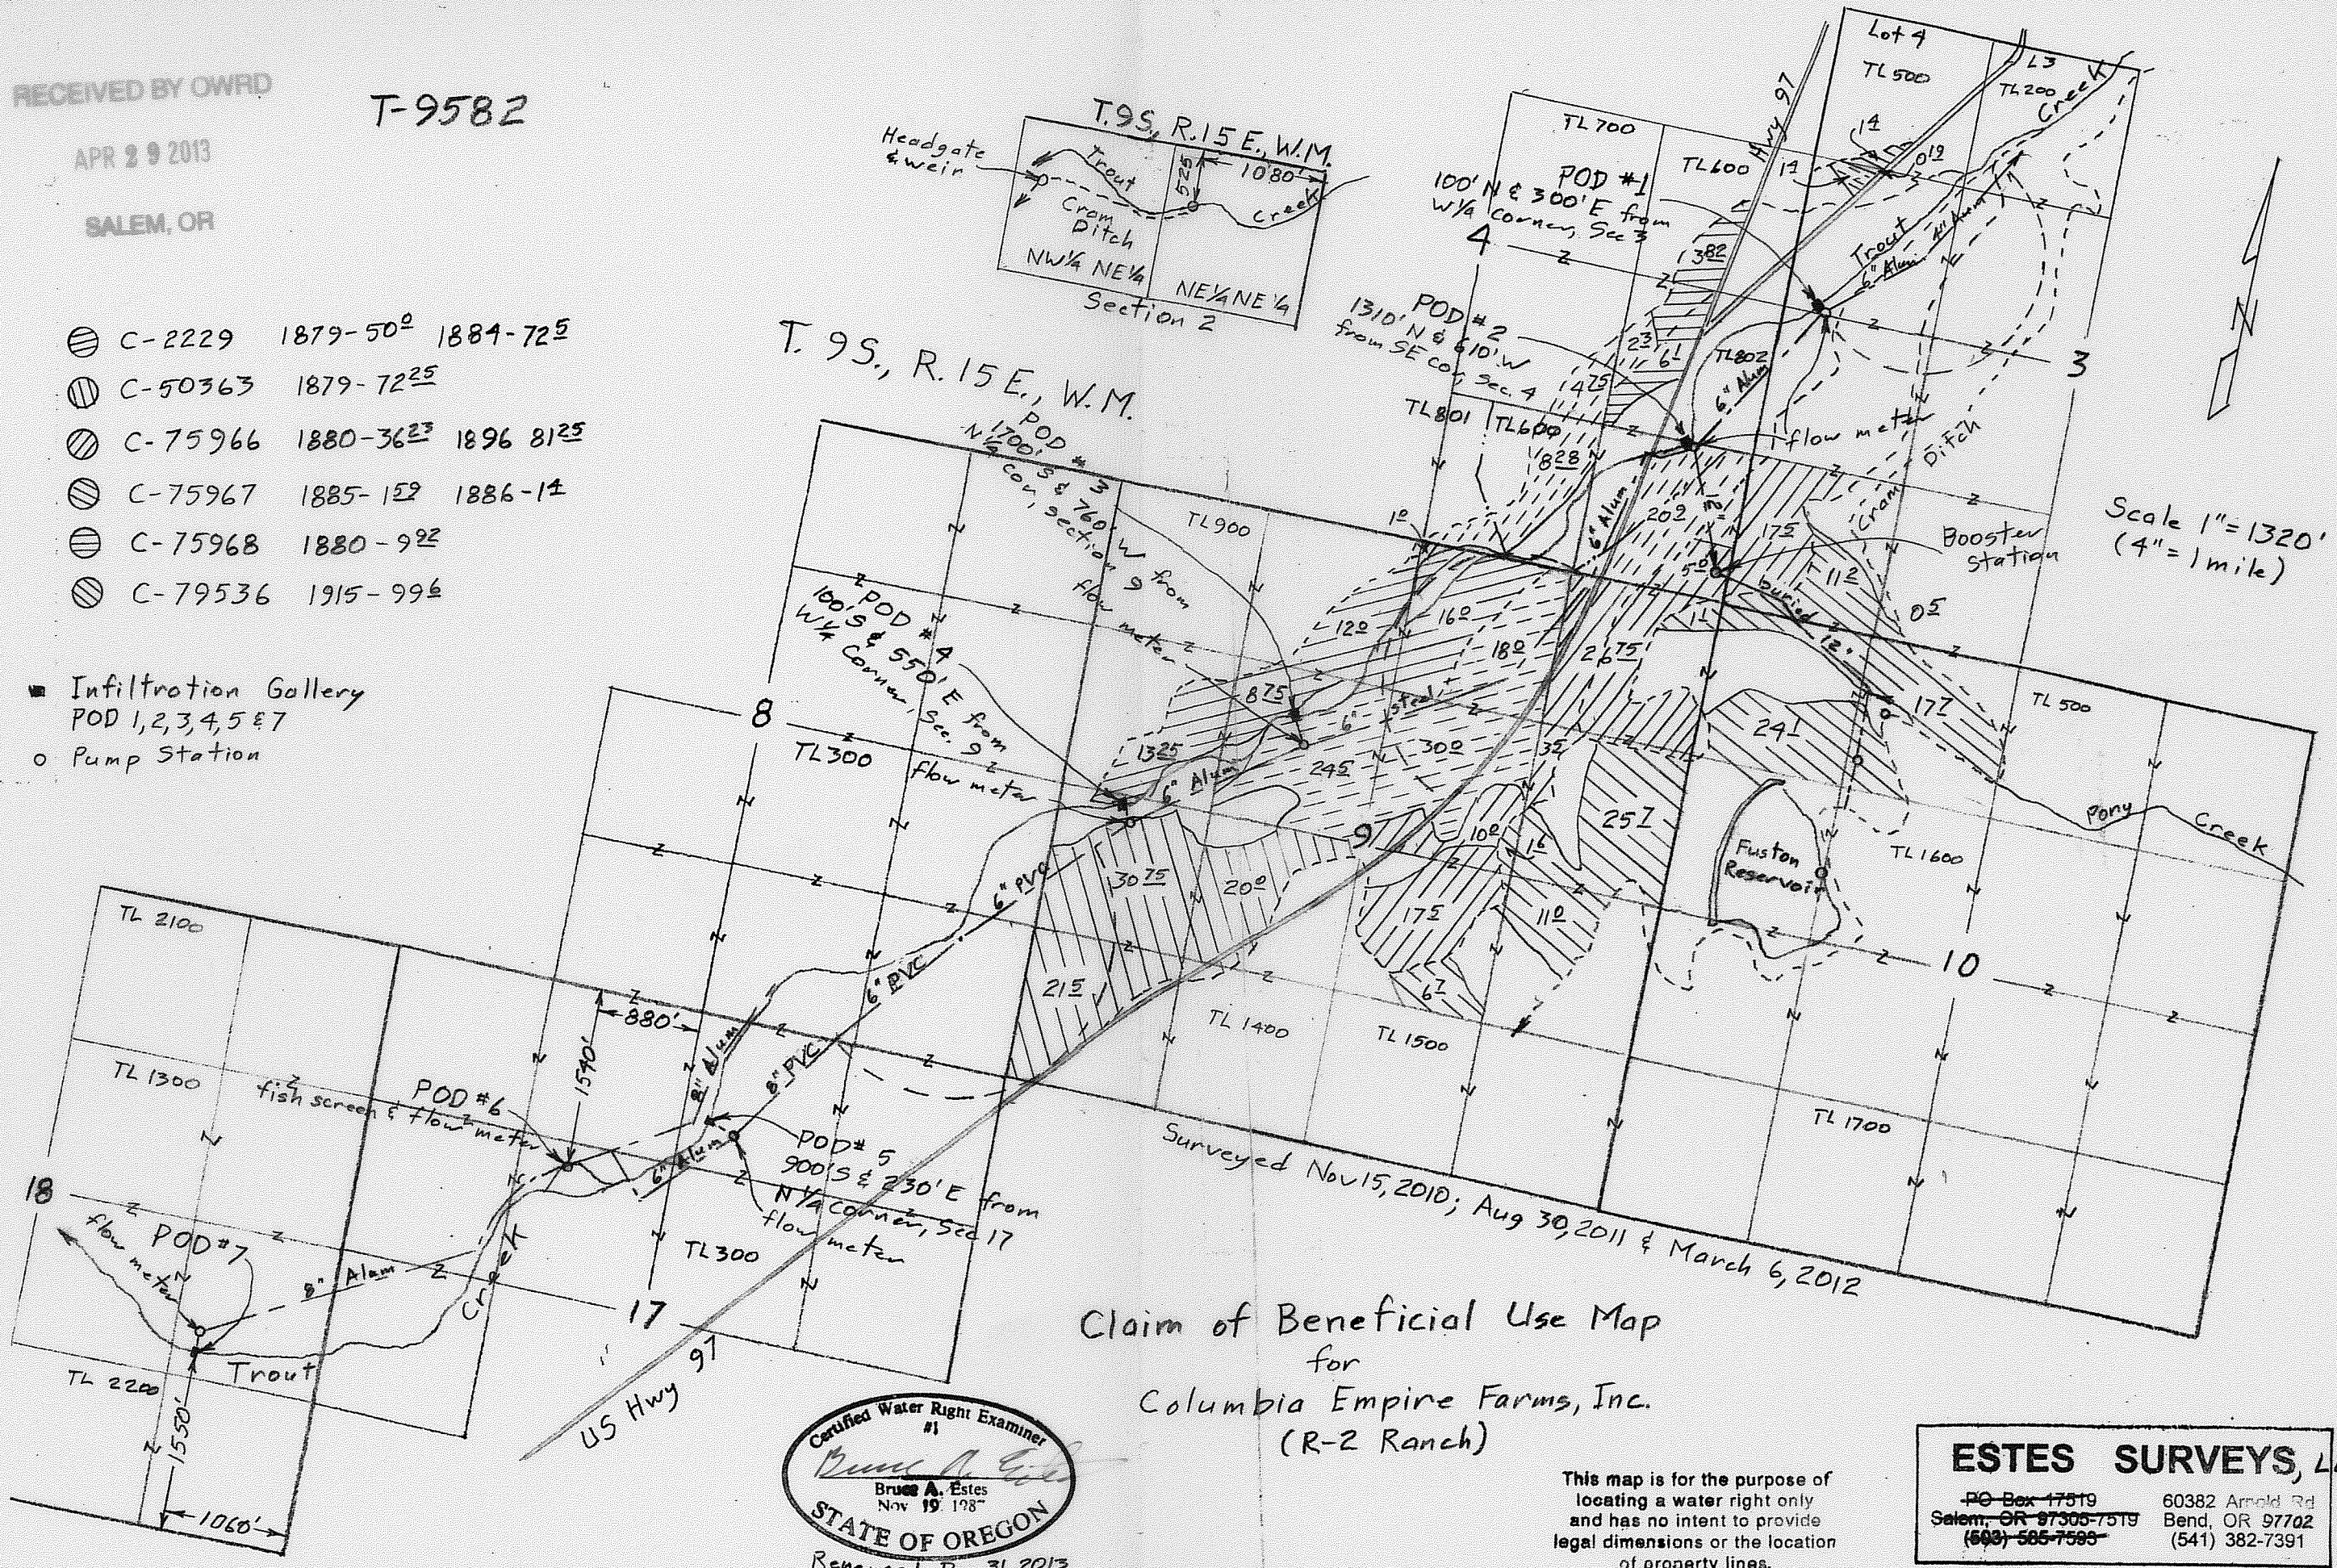

Scale 1" = 1320'
(4" = 1 mile)

Claim of Beneficial Use Map
for
Columbia Empire Farms, Inc.
(R-2 Ranch)

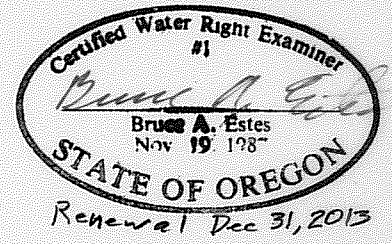

This map is for the purpose of
locating a water right only
and has no intent to provide
legal dimensions or the location
of property lines.

ESTES SURVEYS, LLC
 PO Box 17519 60382 Arnold Rd
 Salem, OR 97305-7519 Bend, OR 97702
 (503) 585-7585 (541) 382-7391