

RECEIVED BY OWRD


APR 29 2013

SALEM, OR

T-9582


- ⊗ C-2229 1879-50⁰ 1884-72⁵
- ⊗ C-50363 1879-72²⁵
- ⊗ C-75966 1880-36²³ 1896 81²⁵
- ⊗ C-75967 1885-12² 1886-14²
- ⊗ C-75968 1880-9²²
- ⊗ C-79536 1915-99⁴

- Infiltration Gallery
POD 1,2,3,4,5 & 7
- Pump Station

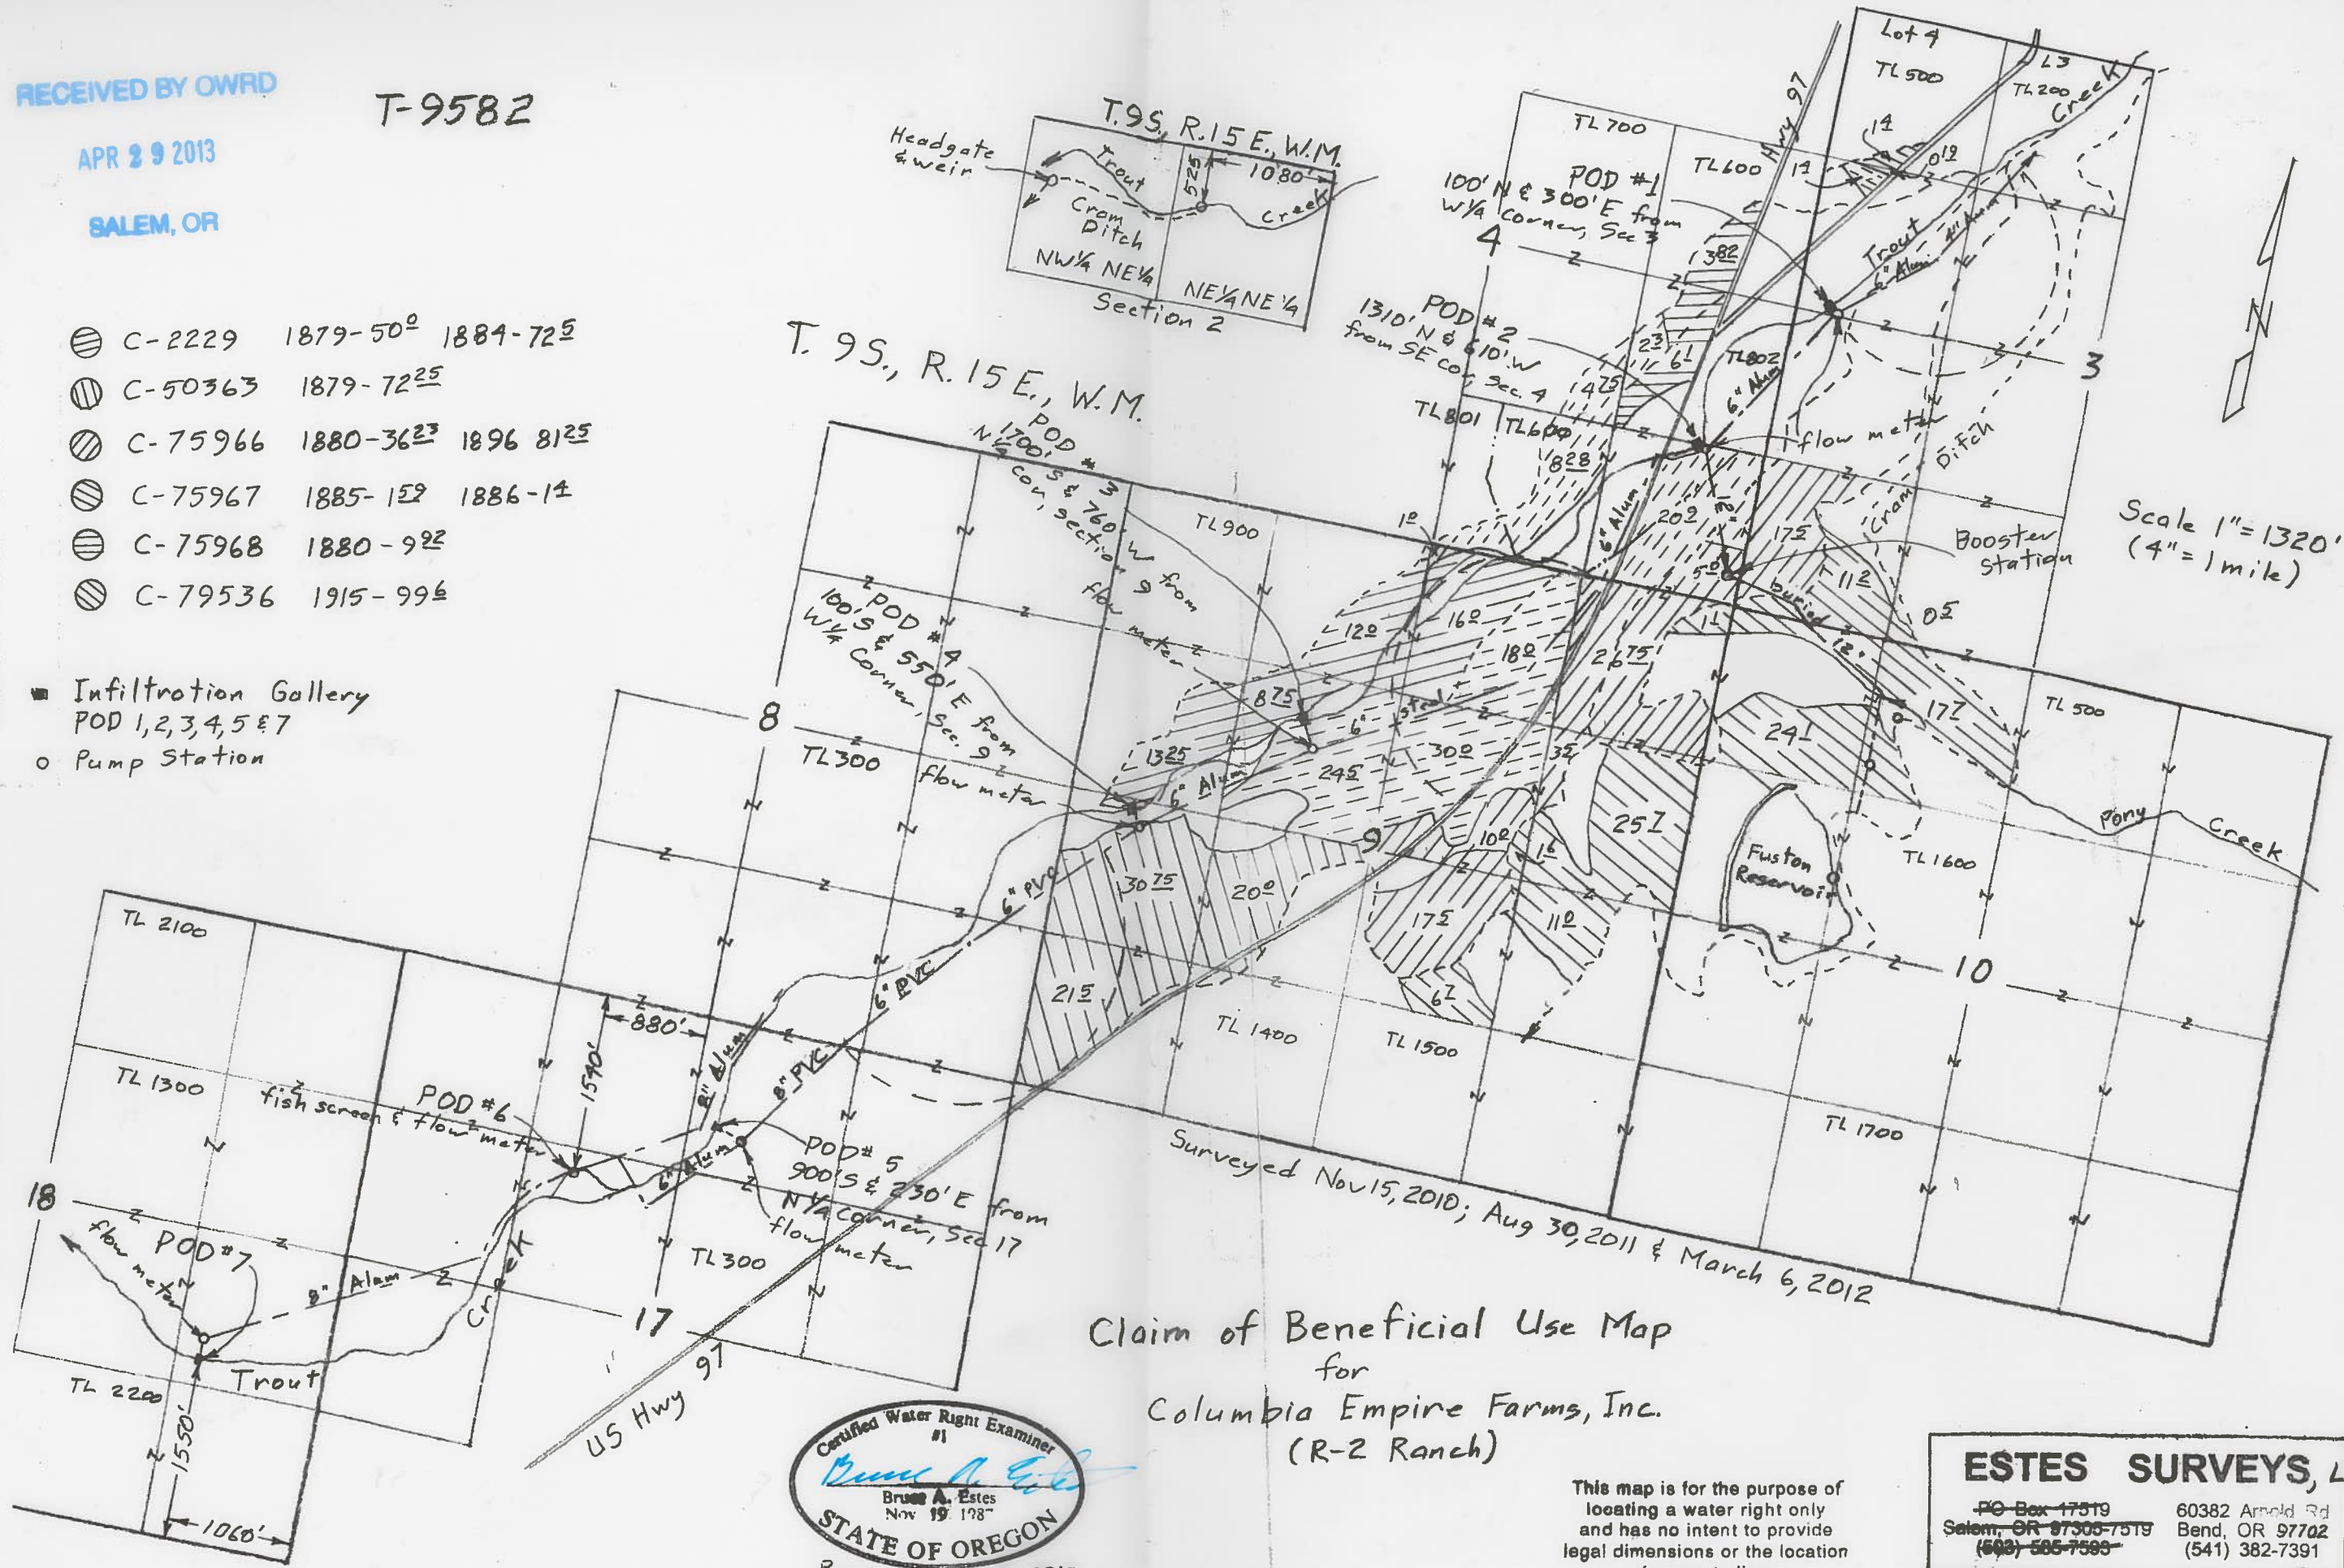

Scale 1" = 1320'
(4" = 1 mile)

Claim of Beneficial Use Map
for
Columbia Empire Farms, Inc.
(R-2 Ranch)

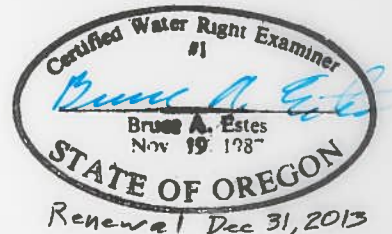

Surveyed Nov 15, 2010; Aug 30, 2011 & March 6, 2012

This map is for the purpose of
locating a water right only
and has no intent to provide
legal dimensions or the location
of property lines.

ESTES SURVEYS, LLC

PO Box 17519
Salem, OR 97305-7519
(503) 585-7593

60382 Arnold Rd
Bend, OR 97702
(541) 382-7391