

RECEIVED BY OWRD


APR 29 2013

SALEM, OR

T-9582

- ⊗ C-2229 1879-50<sup>0</sup> 1884-72<sup>5</sup>
- ⊗ C-50363 1879-72<sup>25</sup>
- ⊗ C-75966 1880-36<sup>23</sup> 1896 81<sup>25</sup>
- ⊗ C-75967 1885-12<sup>2</sup> 1886-14<sup>2</sup>
- ⊗ C-75968 1880-9<sup>22</sup>
- ⊗ C-79536 1915-99<sup>4</sup>


- Infiltration Gallery  
POD 1,2,3,4,5 & 7
- Pump Station

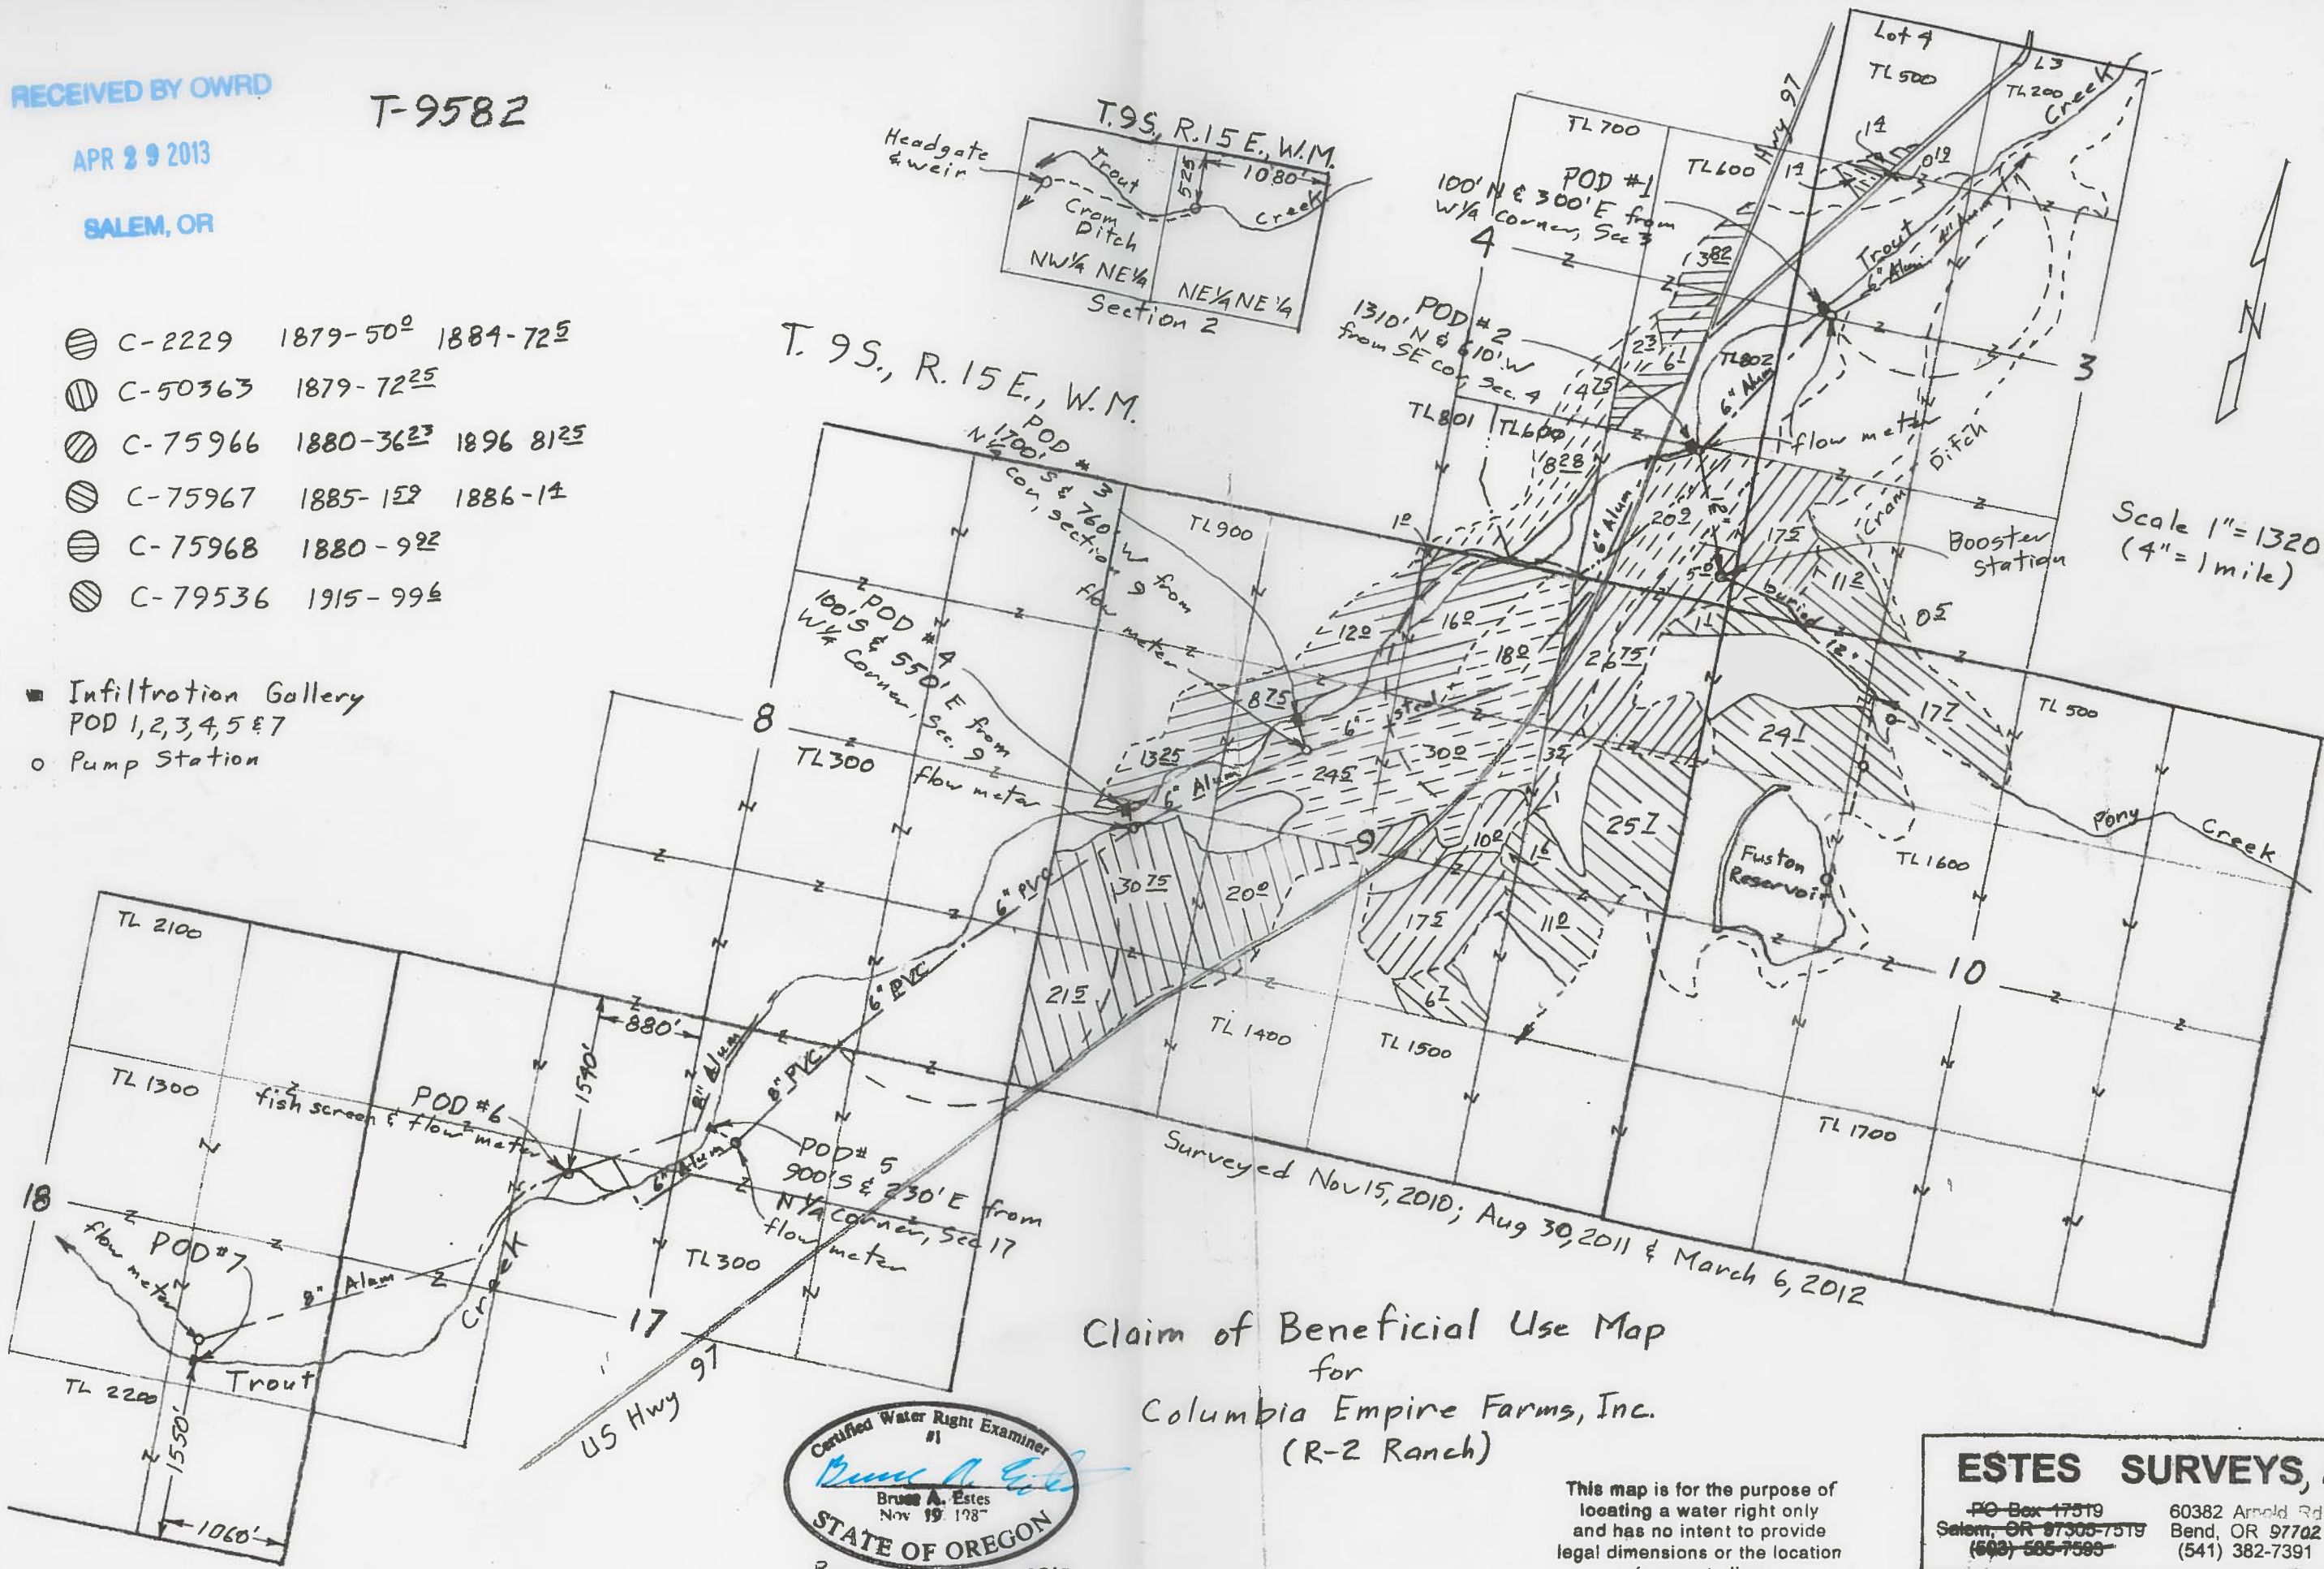

Scale 1" = 1320'  
(4" = 1 mile)

Surveyed Nov 15, 2010; Aug 30, 2011 & March 6, 2012

Claim of Beneficial Use Map  
for  
Columbia Empire Farms, Inc.  
(R-2 Ranch)

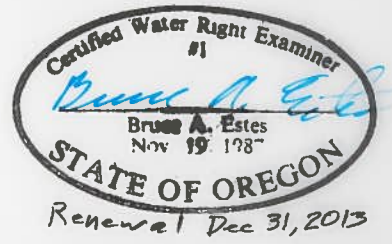

This map is for the purpose of locating a water right only and has no intent to provide legal dimensions or the location of property lines.

**ESTES SURVEYS, LLC**  
 PO Box 17519 Salem, OR 97305-7519 (503) 585-7593  
 60382 Arnold Rd Bend, OR 97702 (541) 382-7391