

RECEIVED BY OWRD


APR 29 2013

SALEM, OR

T-9582

- ⊗ C-2229 1879-50⁰ 1884-72⁵
- ⊗ C-50363 1879-72²⁵
- ⊗ C-75966 1880-36²³ 1896 81²⁵
- ⊗ C-75968 1880-9²²
- ⊗ C-79536 1915-99⁴


- Infiltration Gallery
POD 1,2,3,4,5 & 7
- Pump Station

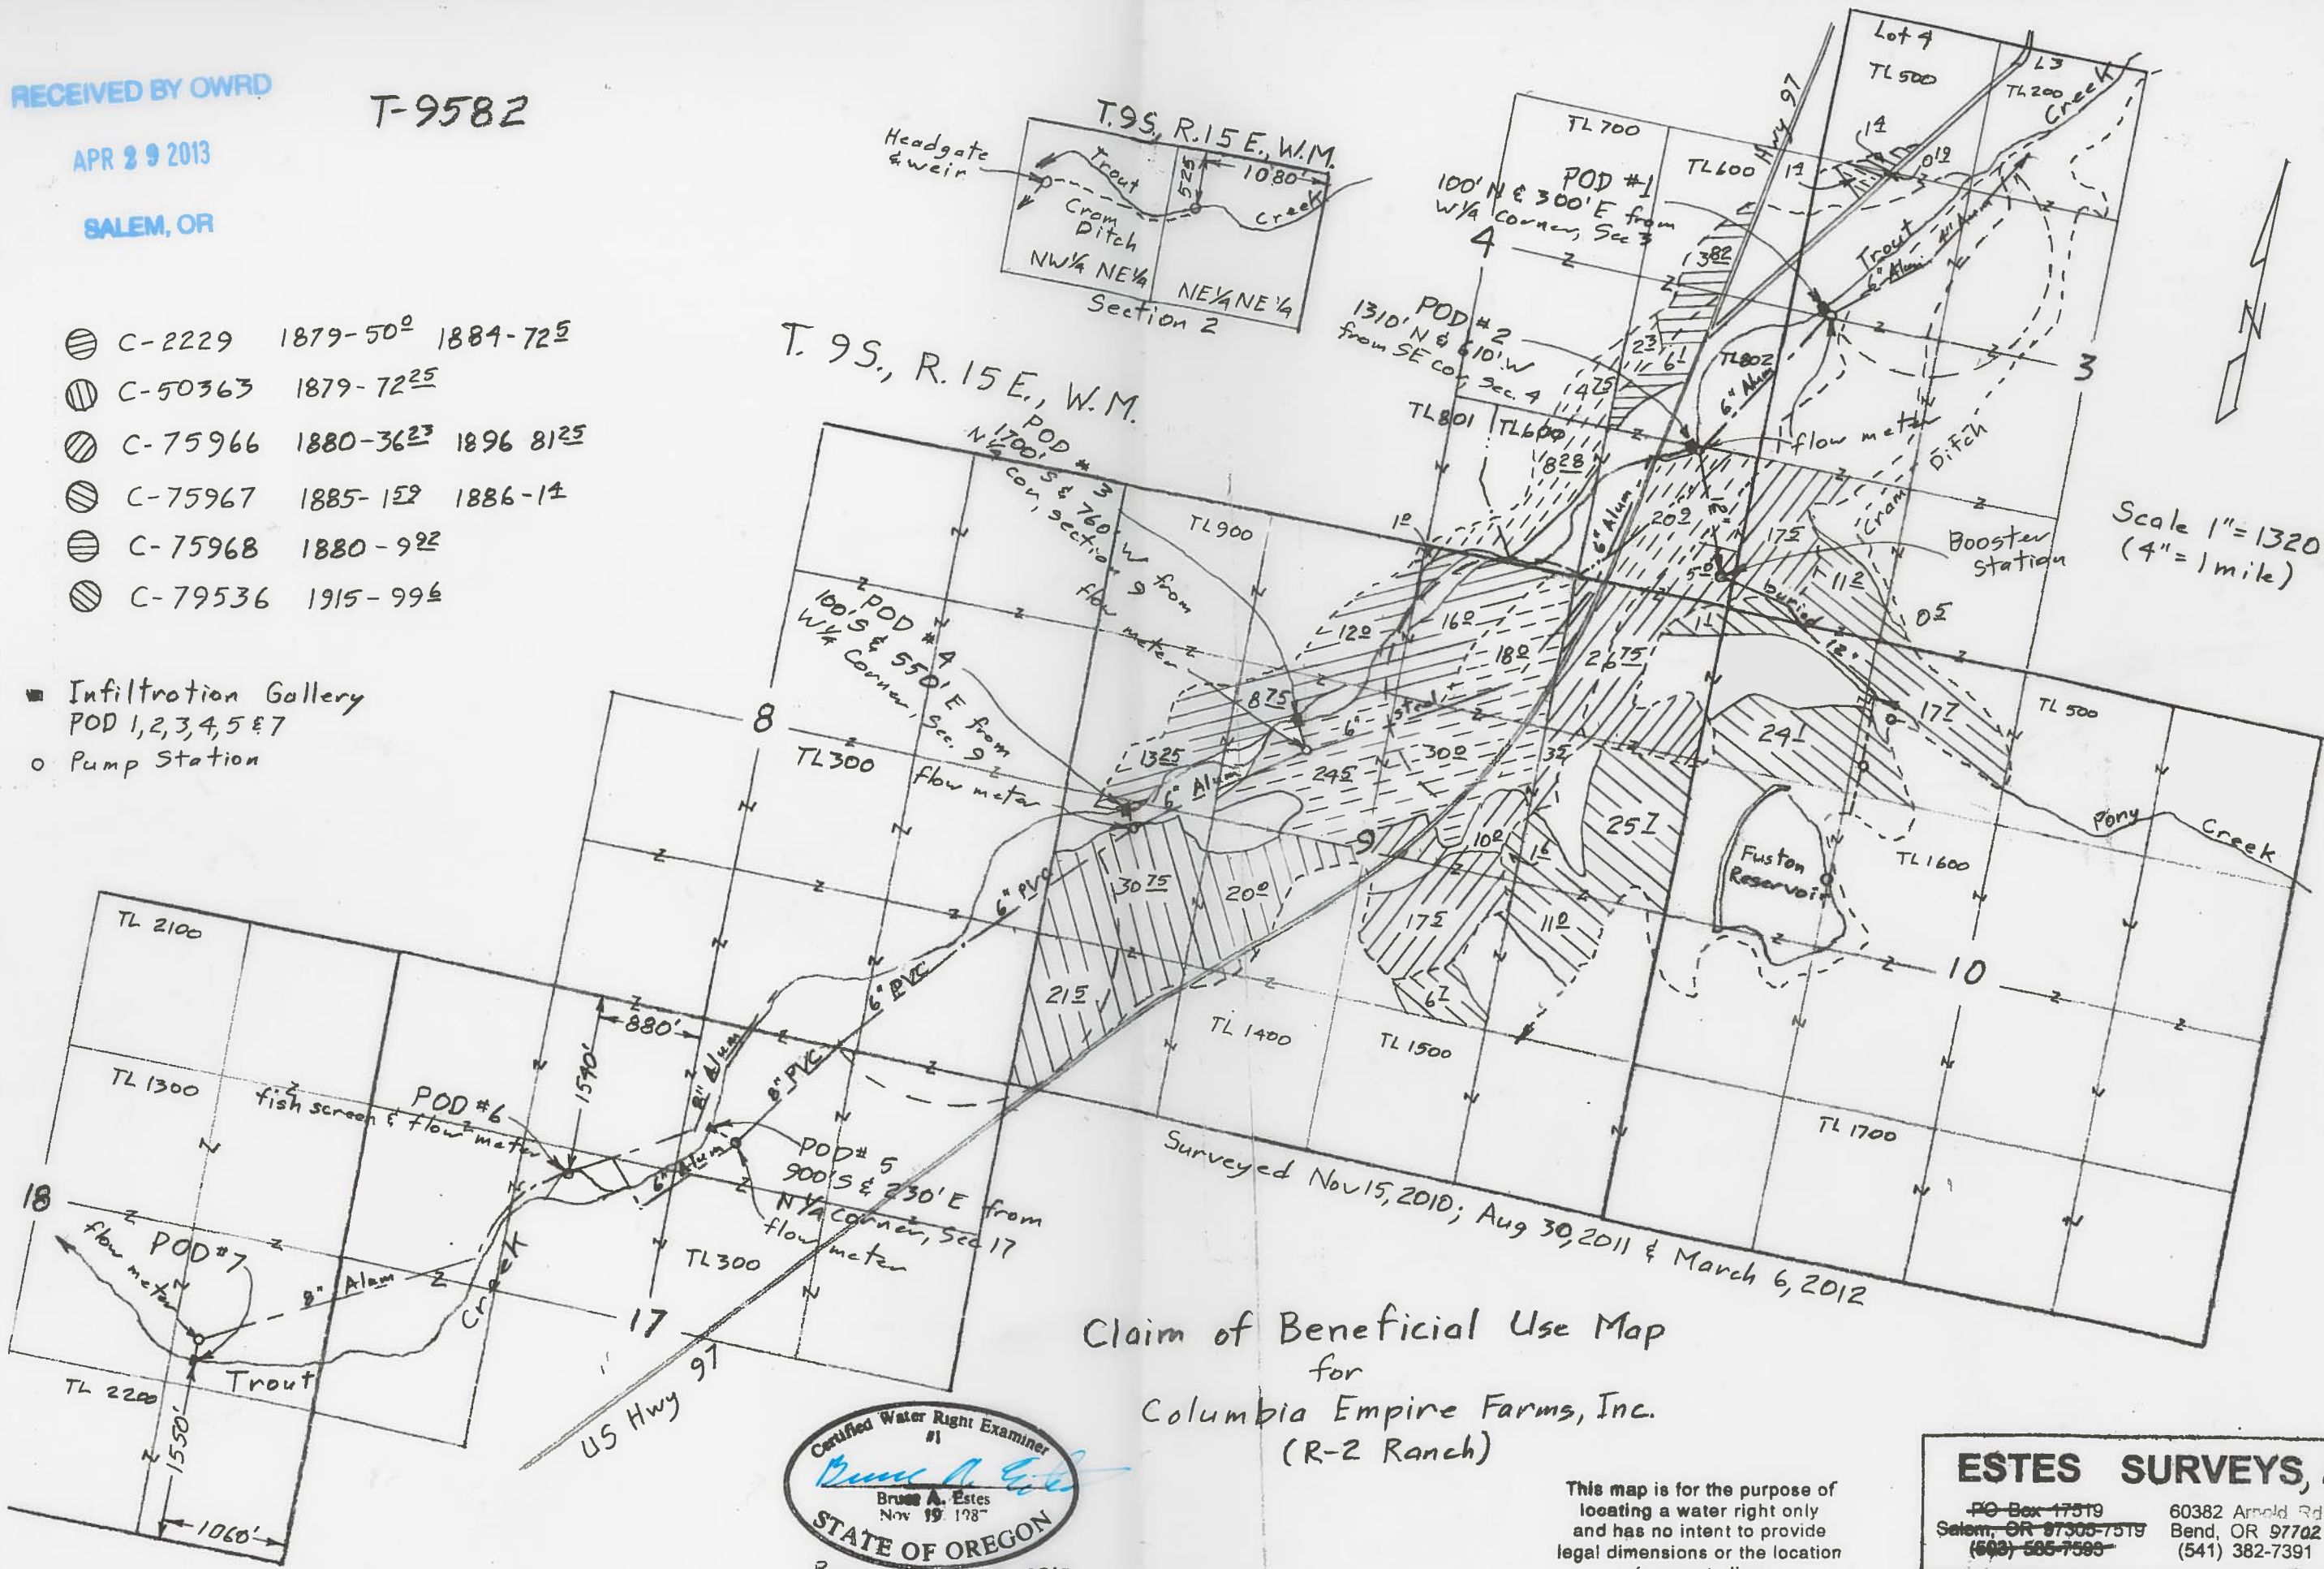

Scale 1"=1320'
(4"=1 mile)

Surveyed Nov 15, 2010; Aug 30, 2011 & March 6, 2012

Claim of Beneficial Use Map
for
Columbia Empire Farms, Inc.
(R-2 Ranch)

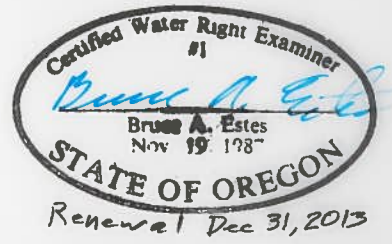

This map is for the purpose of locating a water right only and has no intent to provide legal dimensions or the location of property lines.

ESTES SURVEYS, LLC
 PO Box 17519 Salem, OR 97305-7519 (503) 585-7593
 60382 Arnold Rd Bend, OR 97702 (541) 382-7391