

RECEIVED BY OWRD


APR 29 2013

SALEM, OR


T-9582

- ⊗ C-2229 1879-50⁰ 1884-72⁵
- ⊗ C-50363 1879-72²⁵
- ⊗ C-75966 1880-36²³ 1896 81²⁵
- ⊗ C-75967 1885-12² 1886-14²
- ⊗ C-75968 1880-9²²
- ⊗ C-79536 1915-99⁴

- Infiltration Gallery
POD 1,2,3,4,5 & 7
- Pump Station

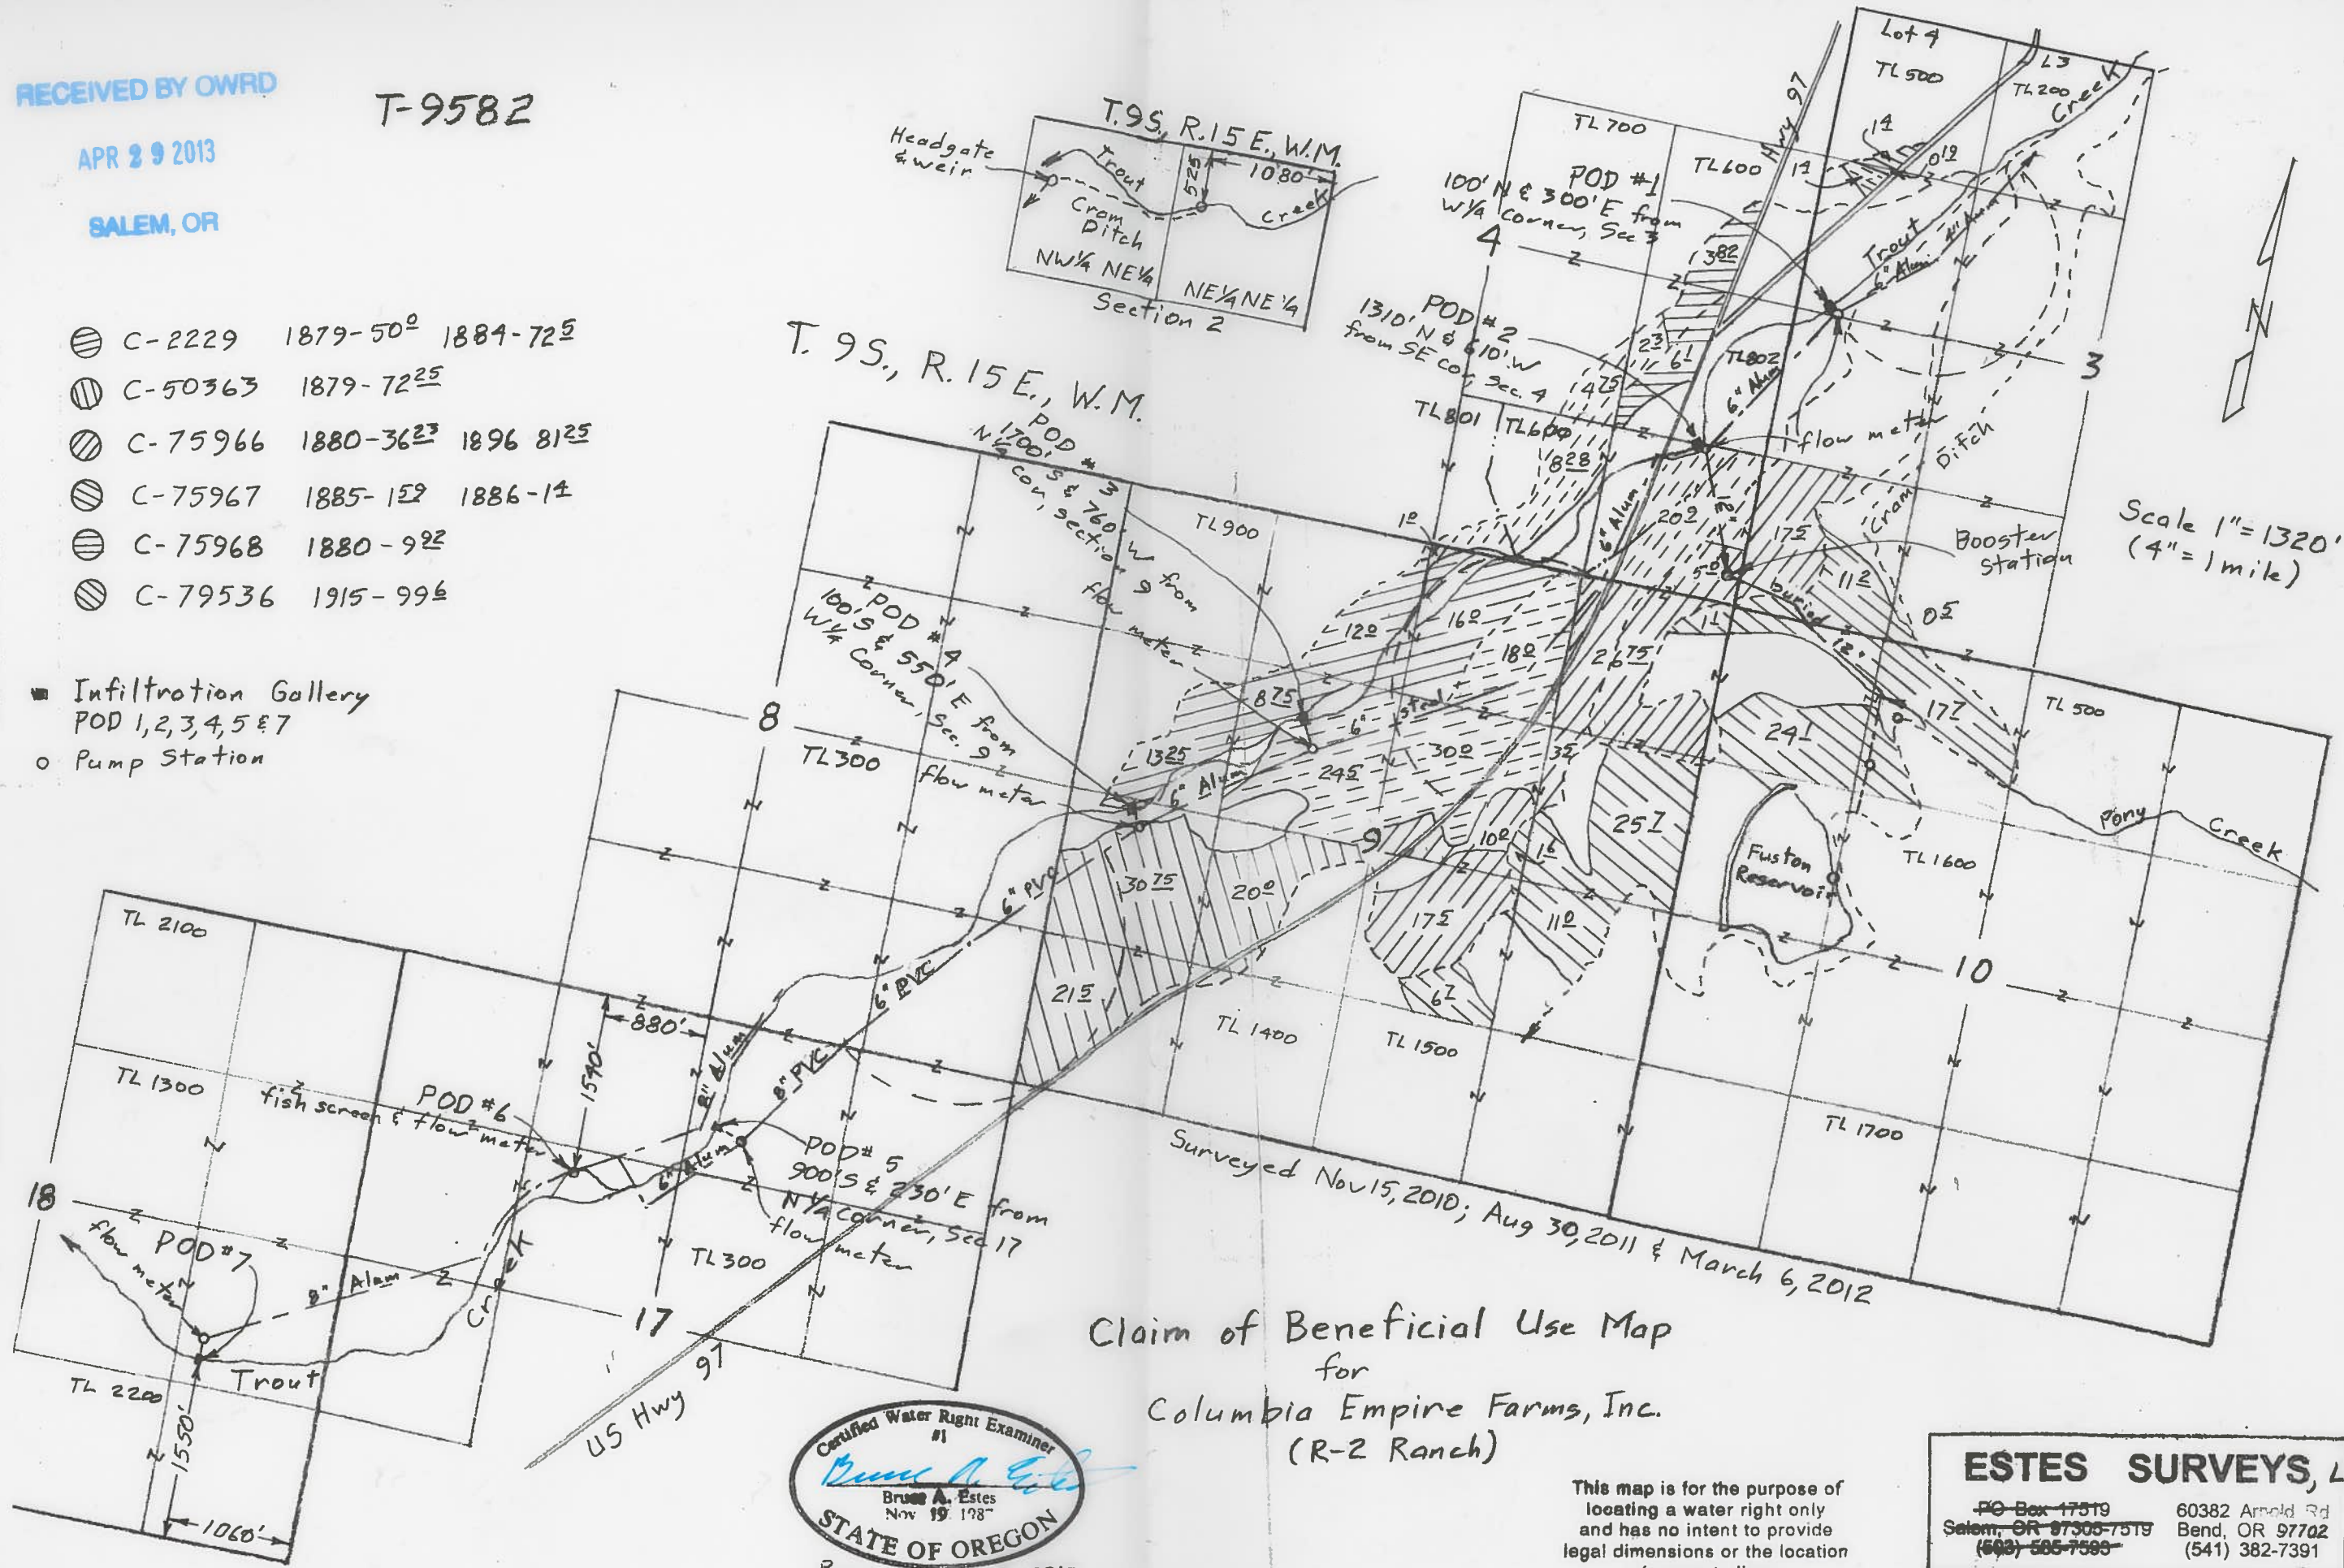

Claim of Beneficial Use Map
for
Columbia Empire Farms, Inc.
(R-2 Ranch)

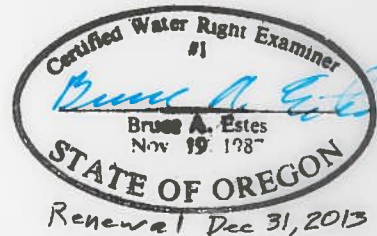

This map is for the purpose of
locating a water right only
and has no intent to provide
legal dimensions or the location
of property lines.

ESTES SURVEYS, LLC
 PO Box 17519 60382 Arnold Rd
 Salem, OR 97305-7519 Bend, OR 97702
 (503) 585-7593 (541) 382-7391