

RECEIVED

MAR 20 2008

**WATER RESOURCES DEPT


CLAIM of BENEFICIAL USE MAP

for


George Stroemple

Under Permits 43218 & 43219

T.34 & 35 S., R. 33 E., W.M.

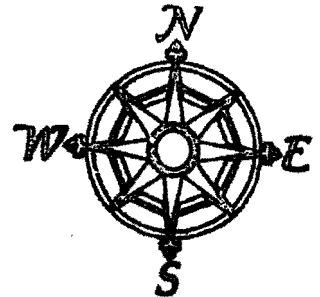

1" = 1320'

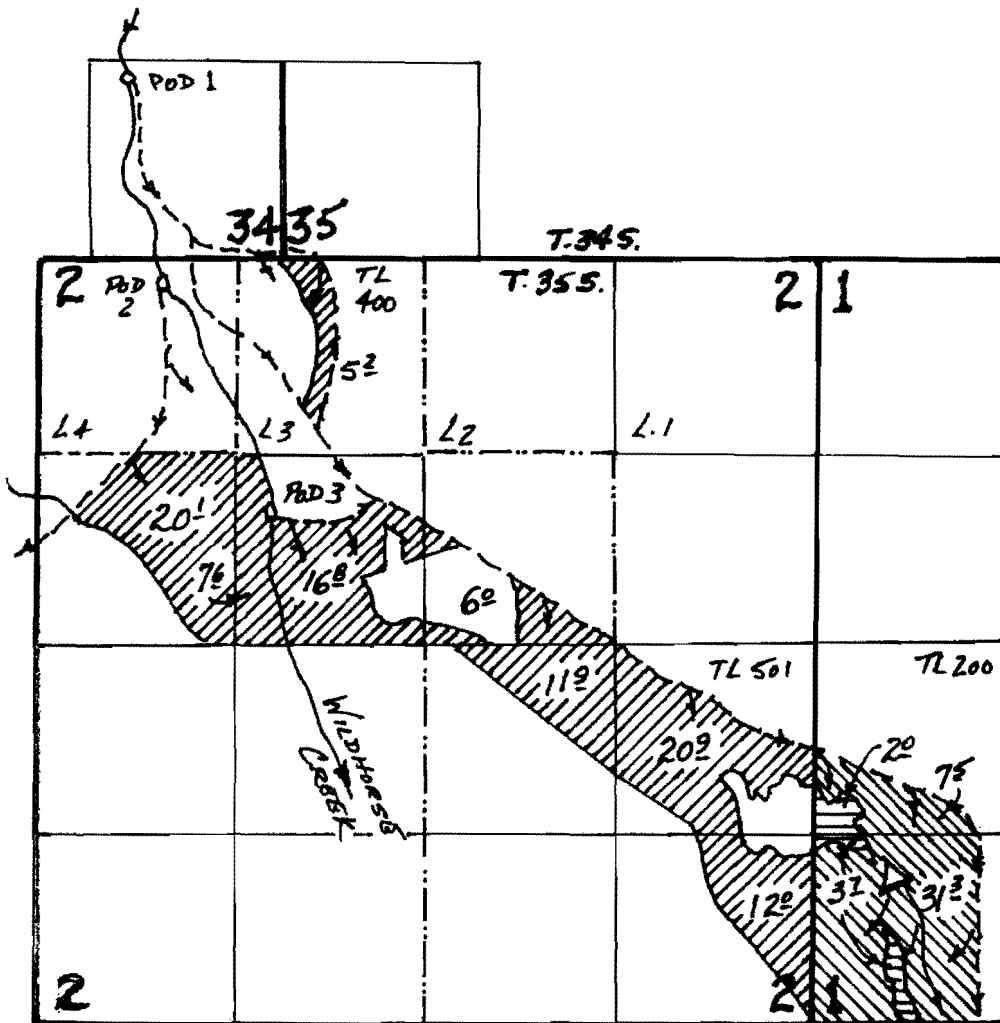

A# 57575, Permit 43218



A# 57576, Permit 43219



Primary
Supplemental

AMENDED 03/26/13

Ronald H. Schuler


POD's Located:

#1- 1250' N. & 1060' W.;

#2- 180' S. & 830' W.;

#3- 1750' S. & 100' W.;

all from the SE Corner Section 34

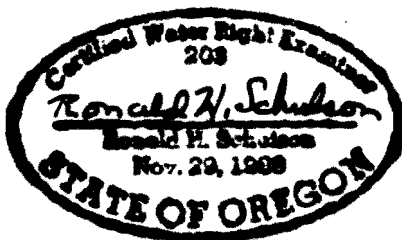

This map is for the purpose of identifying the location of water rights only, and is not intended to provide legal dimensions or locations of property lines.