

T15S R10E, W.M.
Deschutes Co., OR



NE 1/4 SE 1/4

NW 1/4 SW 1/4


Claim of Beneficial Use

T-5493

In the name of George Stroemple

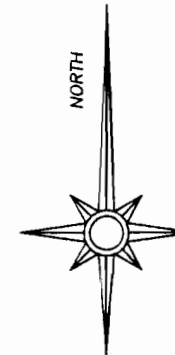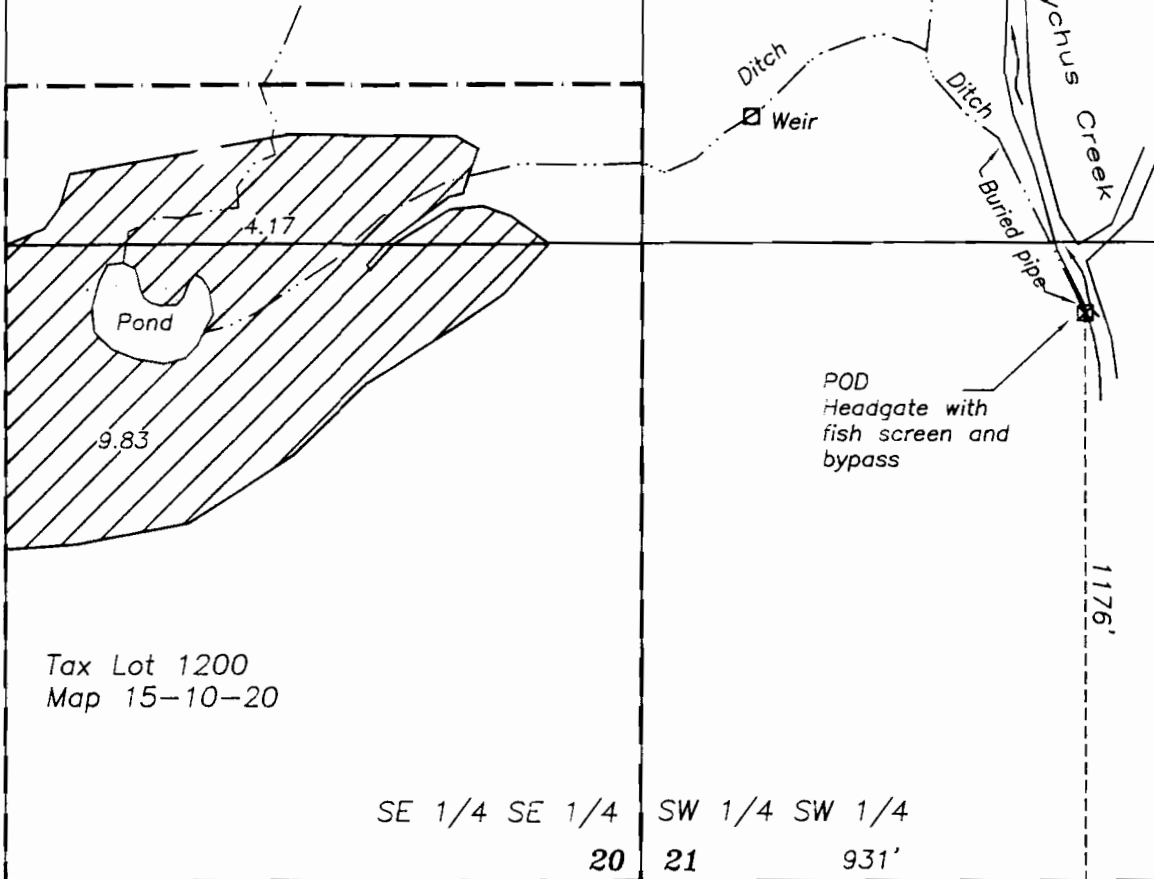

Renewal date: 6/30/2012

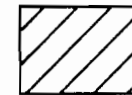

Water beneficially applied under Transfer T-5493, priority date 1883.



Tax lot boundary




Ditch



Point of Diversion (POD)



1/16 Section lines

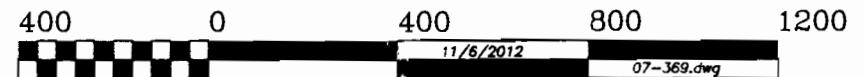

GRAPHIC SCALE - FEET

THIS MAP IS FOR THE PURPOSE OF IDENTIFYING THE LOCATION OF THE WATER RIGHT. IT IS NOT INTENDED TO PROVIDE LEGAL DIMENSIONS OR LOCATIONS OF PROPERTY OWNERSHIP LINES.