


# T.2S. R.39E. W.M.

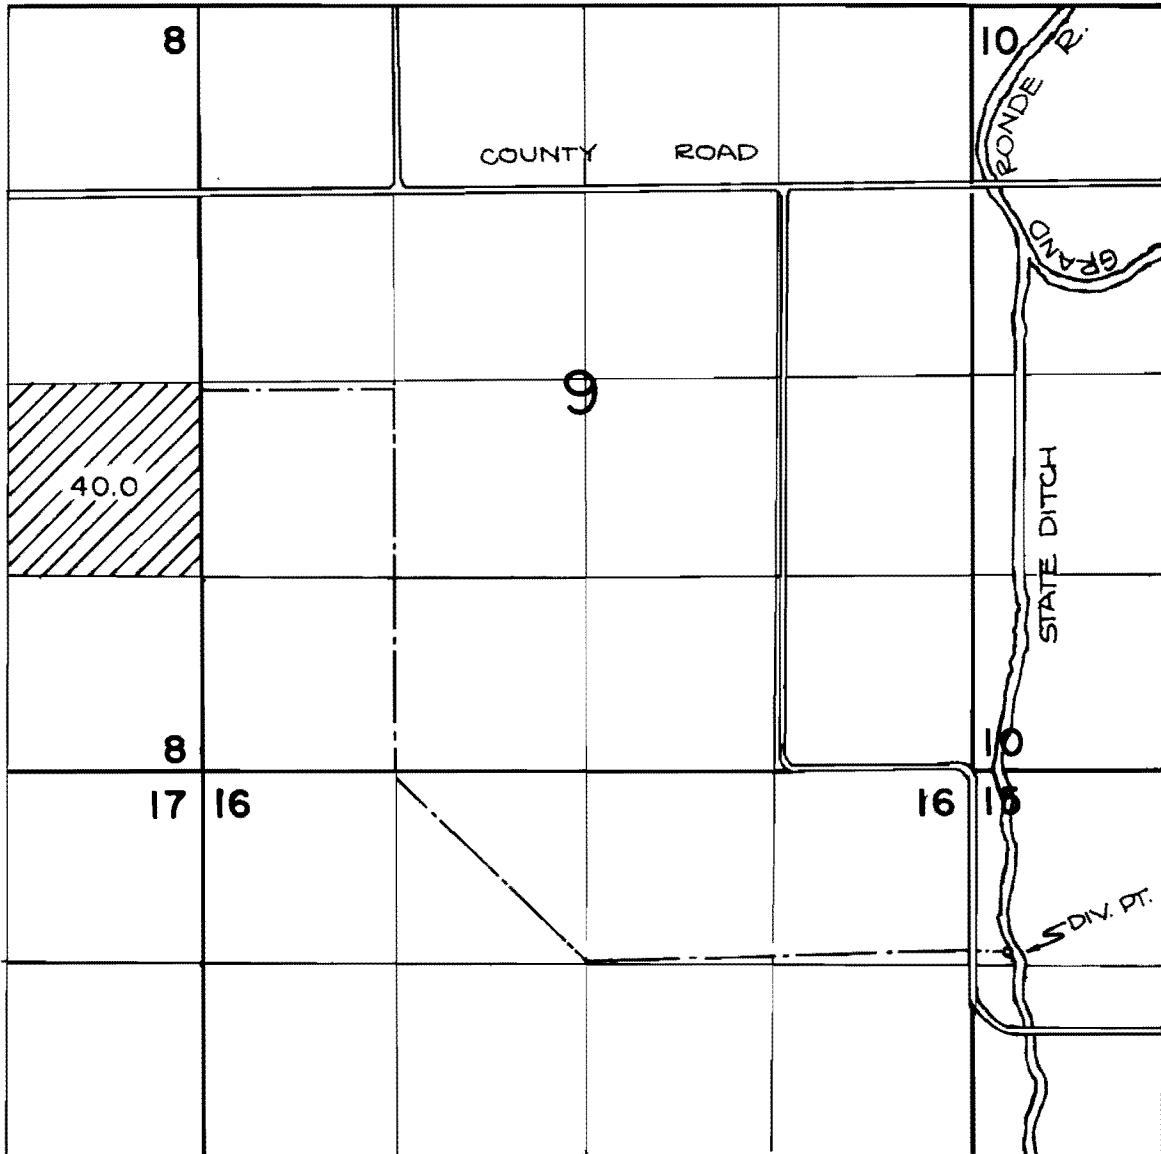

DIVERSION POINT IS LOCATED 1300' S. AND 230' E. FROM THE N.W. CORNER OF SECTION 8 , T.2S., R.39E., W.M.

## FINAL PROOF SURVEY

UNDER

TRANSFER NO. 3687

IN NAME OF

.....CRESTON J. SHAW.....

Surveyed NOV. 17, 1981, by V. CHURCH.....