

CLAIM OF BENEFICIAL USE MAP FOR T-10283

T. 36 S., R. 6 W., W. M., JOSEPHINE COUNTY


Portions of Section 27

March 10, 2012

RECEIVED

MAR 16 2012

WATER RESOURCES DEPT
SALEM, OREGON

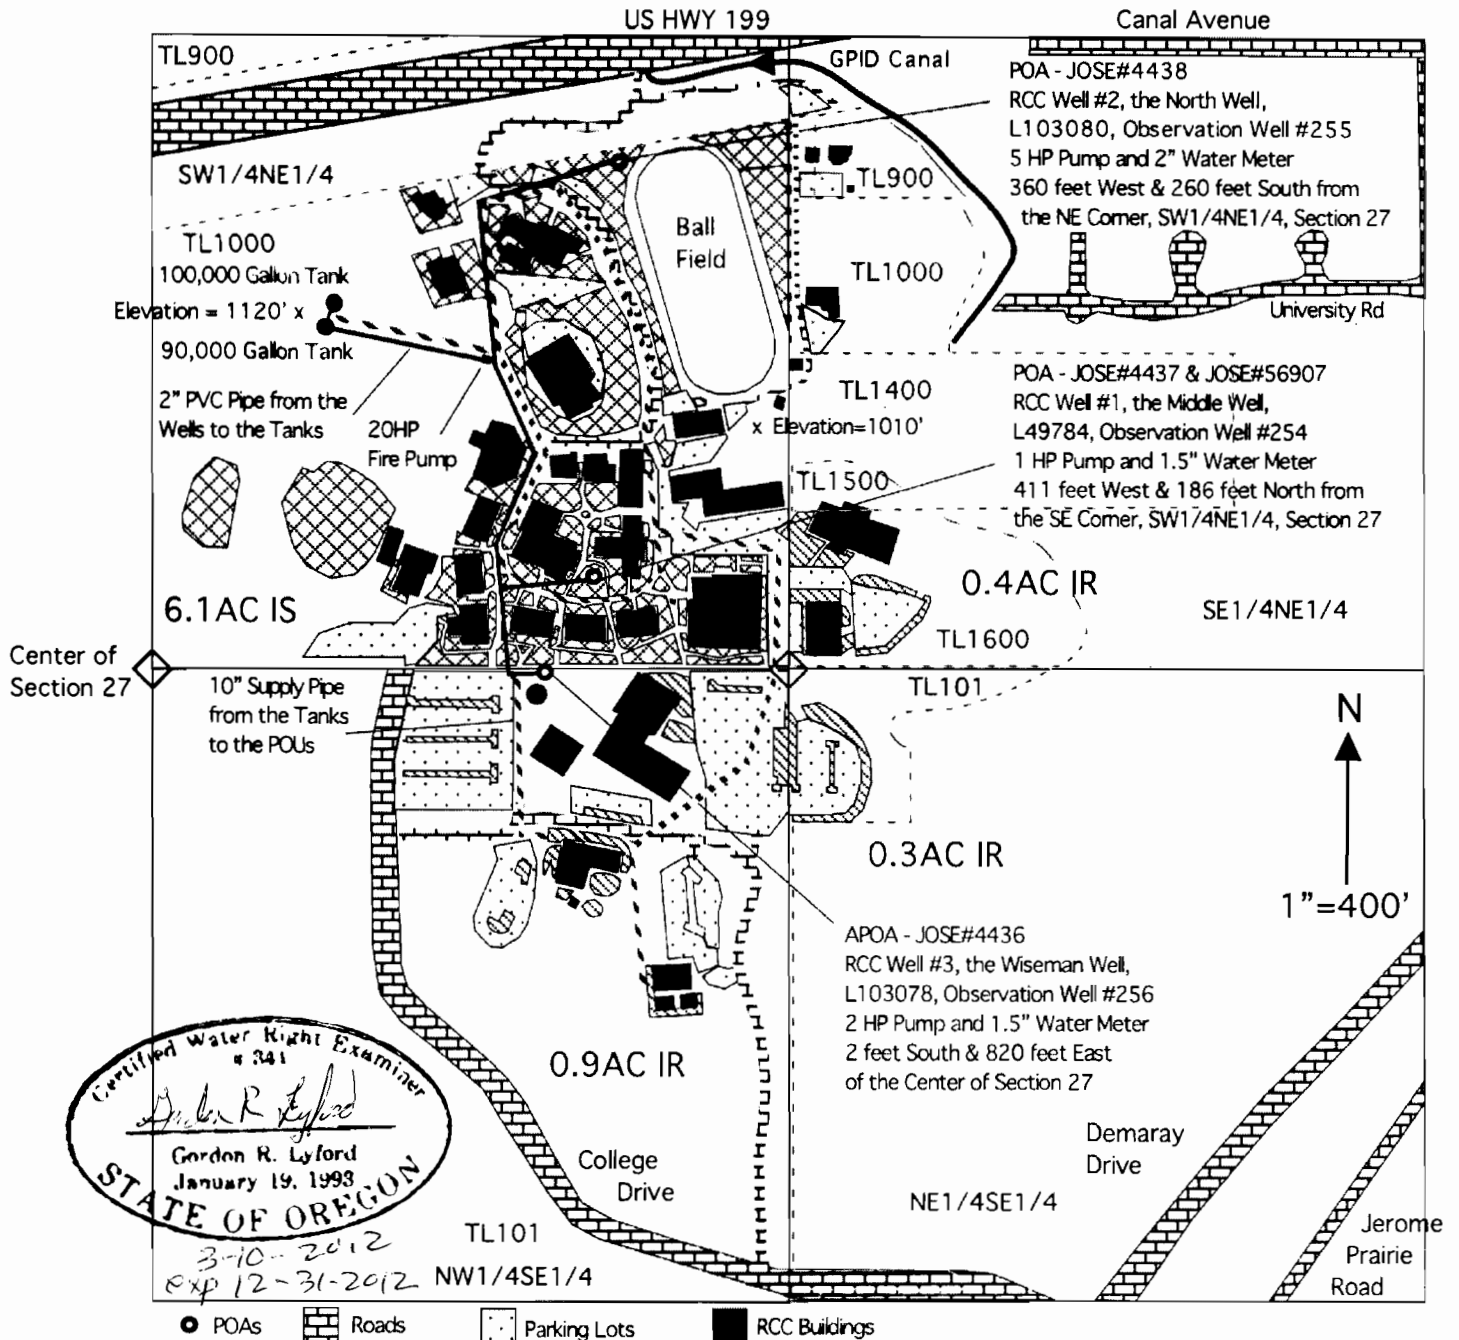

Under Application G-3164 and Permit G-2977 with a rate of 50 gpm and a priority of July 15, 1965.

- Domestic use in a school and fire protection from RCC Wells #1, #2, and #3.
- ▨ 1.6 acres of primary irrigation from RCC Wells #1, #2, and #3.
- ▩ 6.1 acres of supplemental irrigation from RCC Wells #1, #2, and #3 on the existing primary irrigation from Grants Pass Irrigation District (GPID) under Certificate #80972.

This map was drawn by Gordon R. Lyford for Rogue Community College to support their Claim of Beneficial Use under Water Right Transfer T-10283. RCC owns tax lots 101, 900, 1000, 1400, 1500, and 1600.

This map was prepared for the purpose of identifying the location of water rights only and is not intended to provide legal dimensions or the location of property ownership lines.