


# FINAL PROOF SURVEY AND CLAIM OF BENEFICIAL USE

LOCATED IN

NW 1/4, NW 1/4, SECTION 16, T.2N., R.32E., W.M.  
UMATILLA COUNTY, OREGON


APPLICANT: BERT L. & DOROTHY M. JONES  
APPLICATION T-7107 SPECIAL ORDER V.52, P. 880  
PERMIT 652

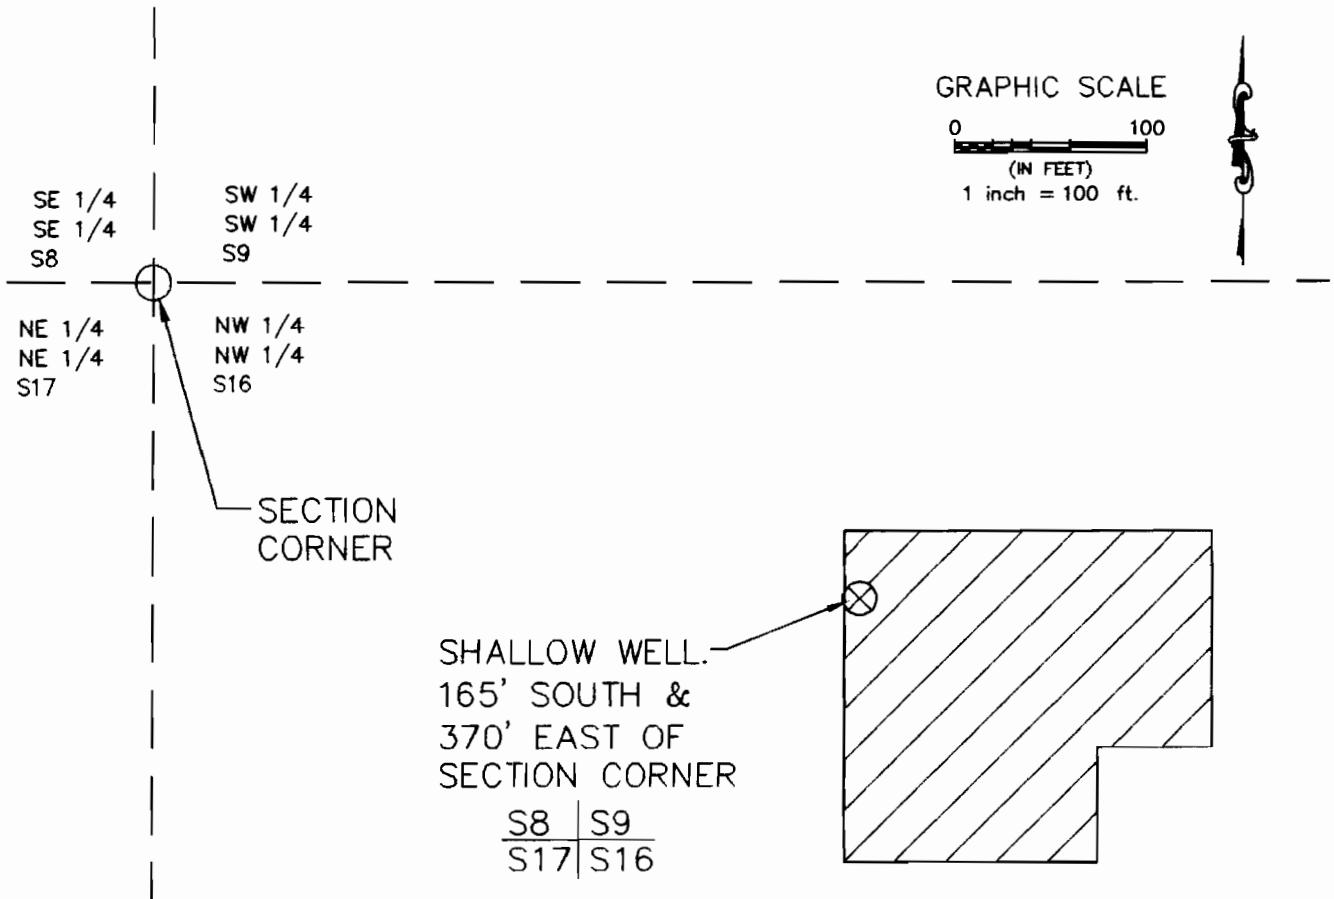

**LEGEND**

AREA BENEFICIALLY IRRIGATED  
0.68 ACRES

This map is prepared for the express purpose to show water appropriation and use. It is not intended to show or locate property ownership lines.

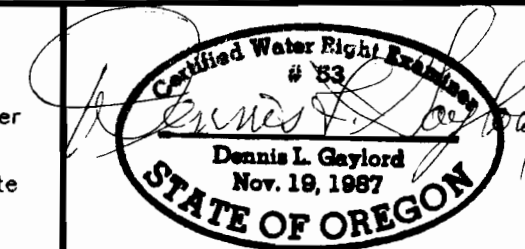

DENNIS L. GAYLORD, CWRE  
71614 S.W. LAKE DRIVE  
PENDLETON, OR 97801  
(541) 276-6260  
July 2, 1999

DRAWN BY: H B WILLIAMS DRAFTING

©

Renews JUNE 30, 2001