


T7S, R1E, WM
MARION COUNTY

RECEIVED
SEP 10 2011
MARION COUNTY CLERK

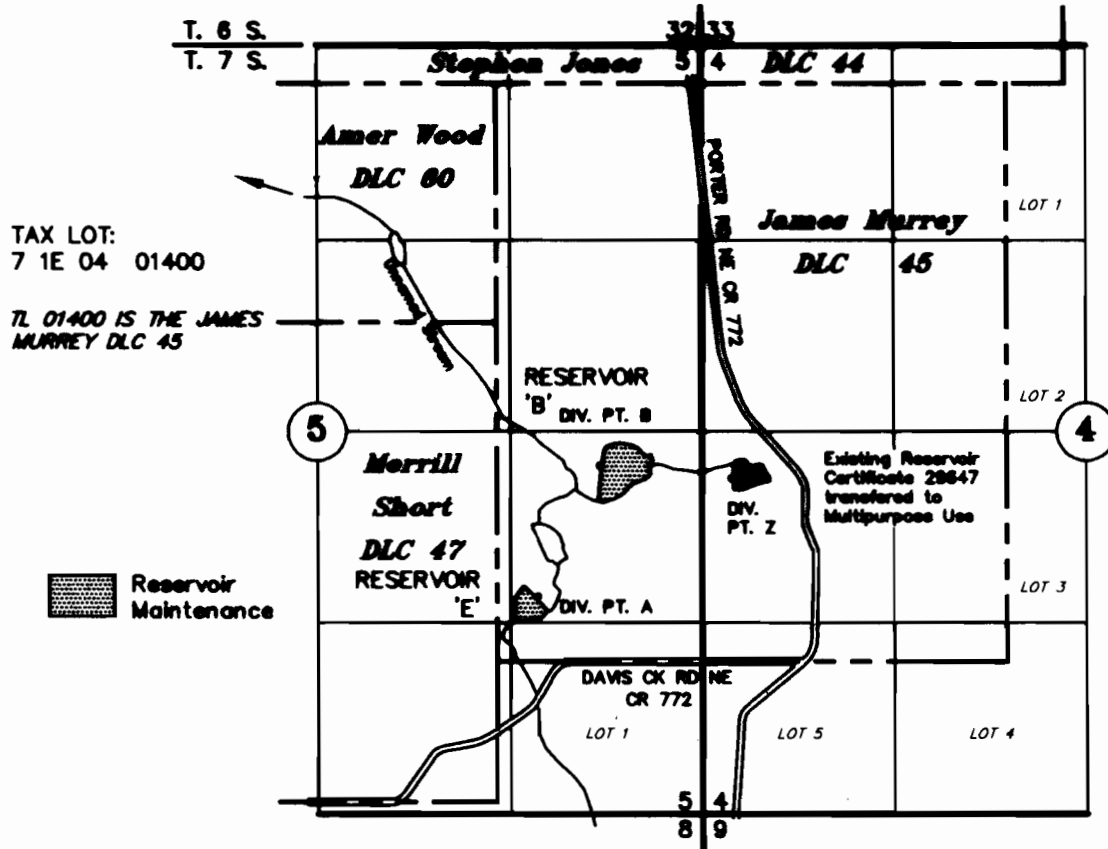

DIV. PT. A LOCATION: 450' N & 282' E OF THE SW COR. OF JAMES MURREY DLC 45
DIV. PT. B LOCATION: 1352' N & 708' E OF THE SW COR. OF JAMES MURREY DLC 45
DIV. PT. Z LOCATION: 1264' N & 1613' E OF THE SW COR. OF JAMES MURREY DLC 45

FINAL PROOF SURVEY

UNDER

Permit No. R-1611
S-22889
R-11605 Transfer Application No. T-6778

IN THE NAME OF

KATHRYN J. ADKINS

SEPTEMBER 1, 2011
SCALE: 1" = 1320'



NOTE: This map is for the purpose of identifying the location of water rights and has no intent to dimension or locate property ownership lines.

RENEWAL DATE: DECEMBER 31, 2011