


RECEIVED

AUG 27 1999

WATER RESOURCES DEPT.
SALEM, OREGON

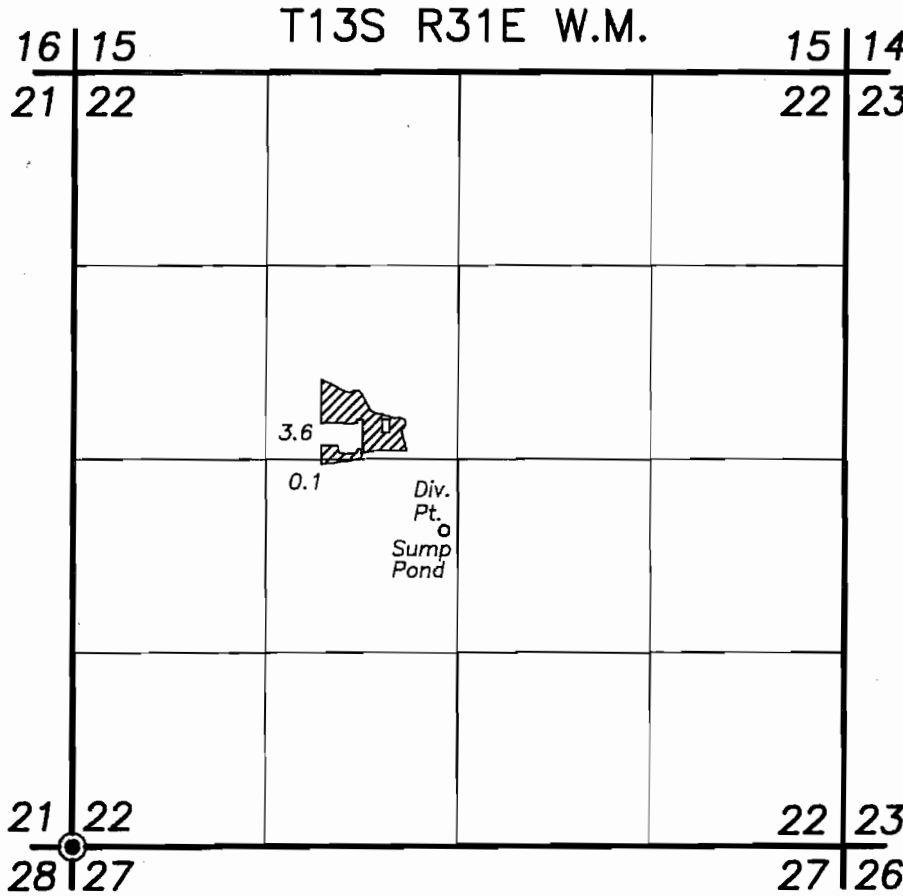

Div. Pt. is 2150' N. and 2550' E. of the SW cor. Sec. 22.

**FINAL PROOF SURVEY
UNDER**

TRANSFER NO. 6671

SPECIAL ORDER VOL. 51, PG. 324-325

IN NAME OF

WILLIAM A. & BLANCHE PATTERSON

SURVEYED AUGUST 6, 1999

BY ROBERT D. BAGETT

 PLACE
OF USE

NOTE: The preparation of this map was for the purpose of identifying the location of the proposed water right and has no intent to provide dimensions or location of property ownership lines. Location information shown hereon was furnished by the applicant.

