
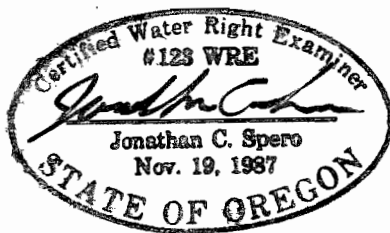


T.39 S. R.08 W. SECTION 4 W.M.

CLAIM OF BENEFICIAL USE MAP

UNDER TRANSFER No. T - 8176
MODIFYING A PORTION OF CERT. 75116

IN NAME OF: J.A. KEIFER

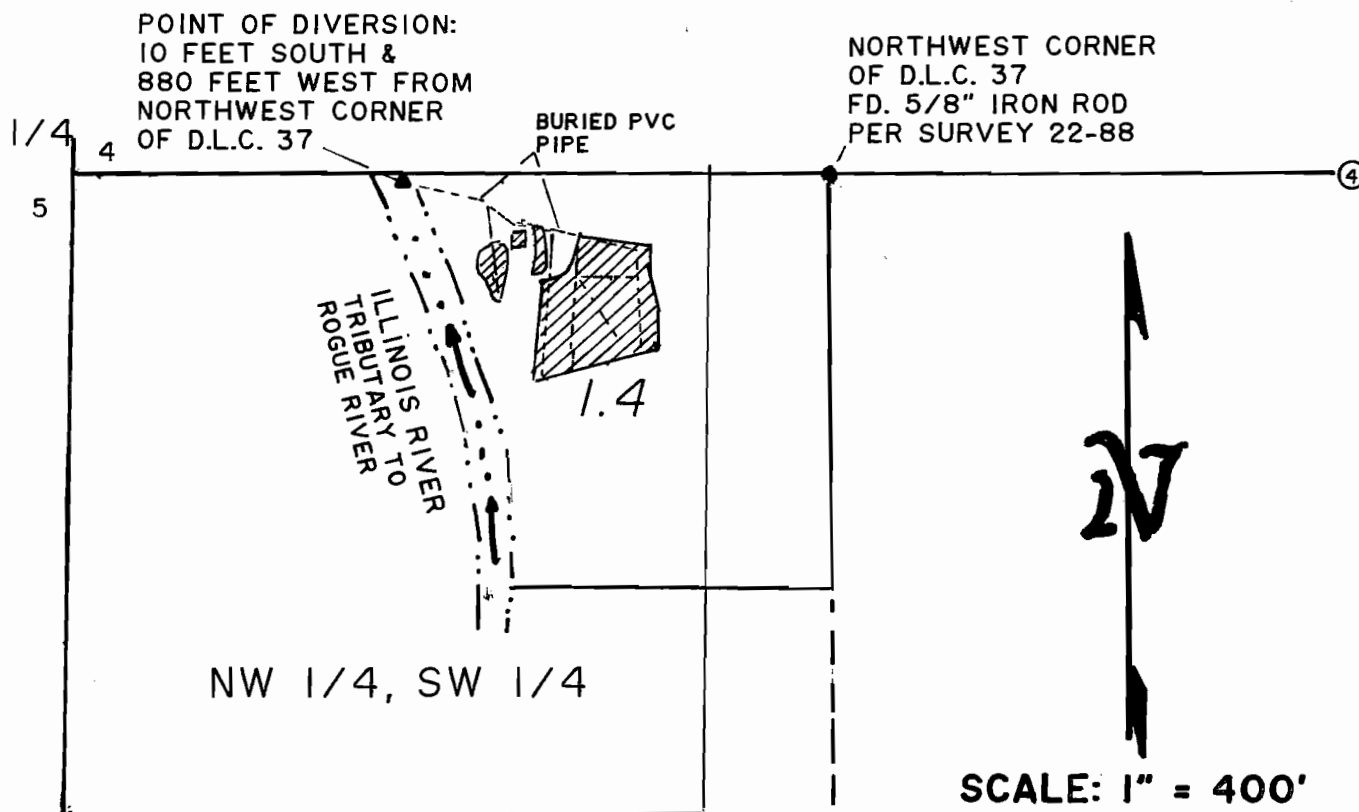

LICENSE RENEWAL DATE:
JUNE 30, 2002

SURVEYED AUGUST 6, 2001

BY:

**JONATHAN C. SPERO C.W.R.E. 123
1002 KINCAID RD./P.O. BOX 16
WILLIAMS, OREGON 97544
PH. (541) 846-6845**

THIS MAP IS FOR THE PURPOSE OF
IDENTIFYING THE LOCATION OF THE
WATER RIGHT ONLY, AND IS NOT IN-
TENDED TO PROVIDE LEGAL DIMEN-
SIONS OR LOCATIONS OF PROPERTY
OWNERSHIP LINES.