

Claim of Beneficial Use


In The Name of

Daniel & Penelope McCue

T26S-R6W-S14 & 23
Tax Lot: 700

T/L 700= 1.33ac
R26308 & R26316
1.08ac 0.25ac

Application: T-6611
Permit: T-6611

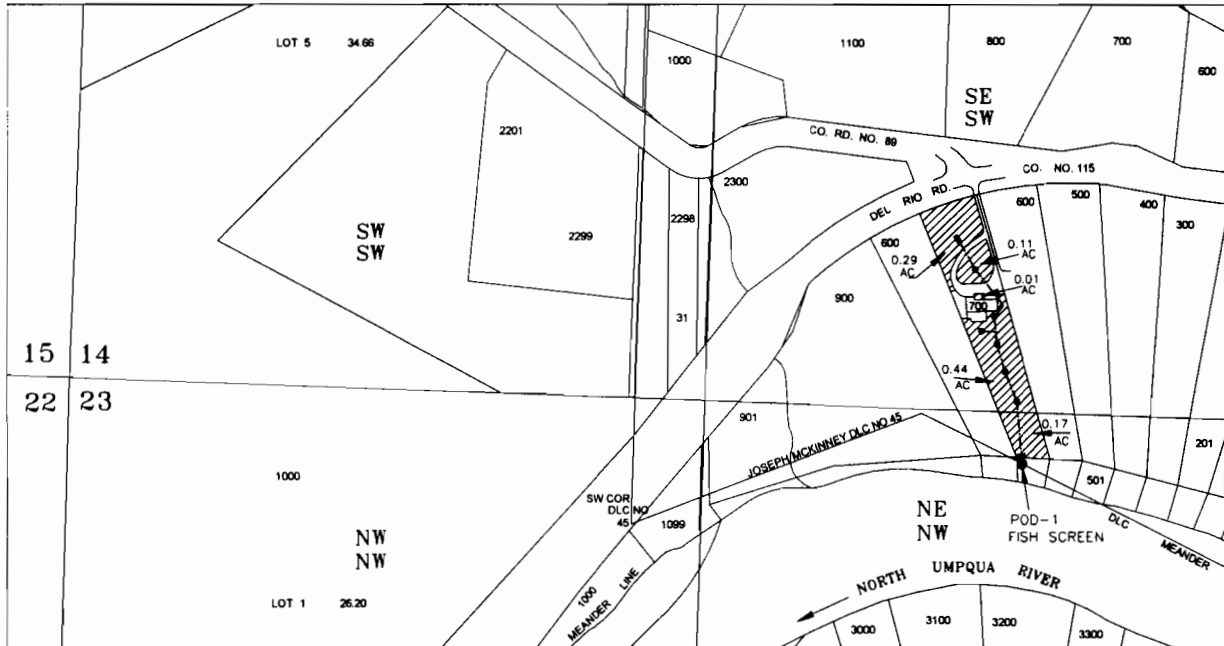



Irrigation of:
PLACE OF USE: Lawn, Garden & Landscaping

Irrigation: Total Acres= 1.02 AC
Within D.L.C. 45= 1.02 AC
Sec. 14 SE/SW= 0.85 AC
Sec. 23 NE/NW= 0.17 AC

LEDGEND:

- Spigot stand
- Sprinkler head some w/spigot
- 1-1/2" buried poly pipe
- POD-1 & Fish Screen

POD-1 & Fish Screen: More or less 1,974 feet East and 181 feet South from the NW corner of Section 23, common with 14, 15 & 22. within the DLC. 45, Joseph McKinney.

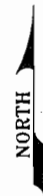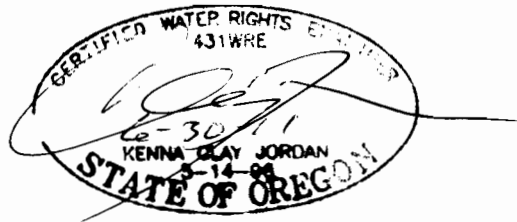

1" = 400'

This map is not intended to provide legal dimensions and/or locations of property ownership lines.

Locations per 1/4 1/4 are derived by assumed fit of aerial photo orientation to ground surveys and/or tax assessor maps.

JORDAN ENGINEERING
460 JORDAN LANE
ROSEBURG, OREGON 97471
(541) 673-1931

12-01-10