


T.18S., R.6W., W.M.
 Sections 8 & 9
 Rosboro Lumber CO. LLC
 Tax Lot 504
 Map 18060800
 Lane County, Oregon
 April 27, 2009

Application # T-7877
 Permit # G-3972

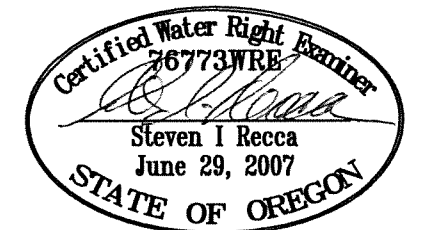

EXPIRATION DATE: 12/31/10

RECEIVED


OCT 01 2009

WATER RESOURCES DEPT
 SALEM, OREGON



BASE MAPPING BY LANE COUNTY TAX MAPS
 18060400, 18060800 AND 18060900. THIS MAP HAS
 BEEN PREPARED FOR THE SOLE PURPOSE OF
 IDENTIFYING THE REQUESTED WATER RIGHT
 LOCATION. THERE IS NO INTENT TO PROVIDE
 DIMENSIONS OR LOCATIONS OF PROPERTY
 OWNERSHIP LINES.

EGR & Associates, Inc.
 Engineers, Geologists and Surveyors
 2535B Prairie Road Eugene, Oregon 97402 (541) 688-8322
 Fax (541) 688-8087

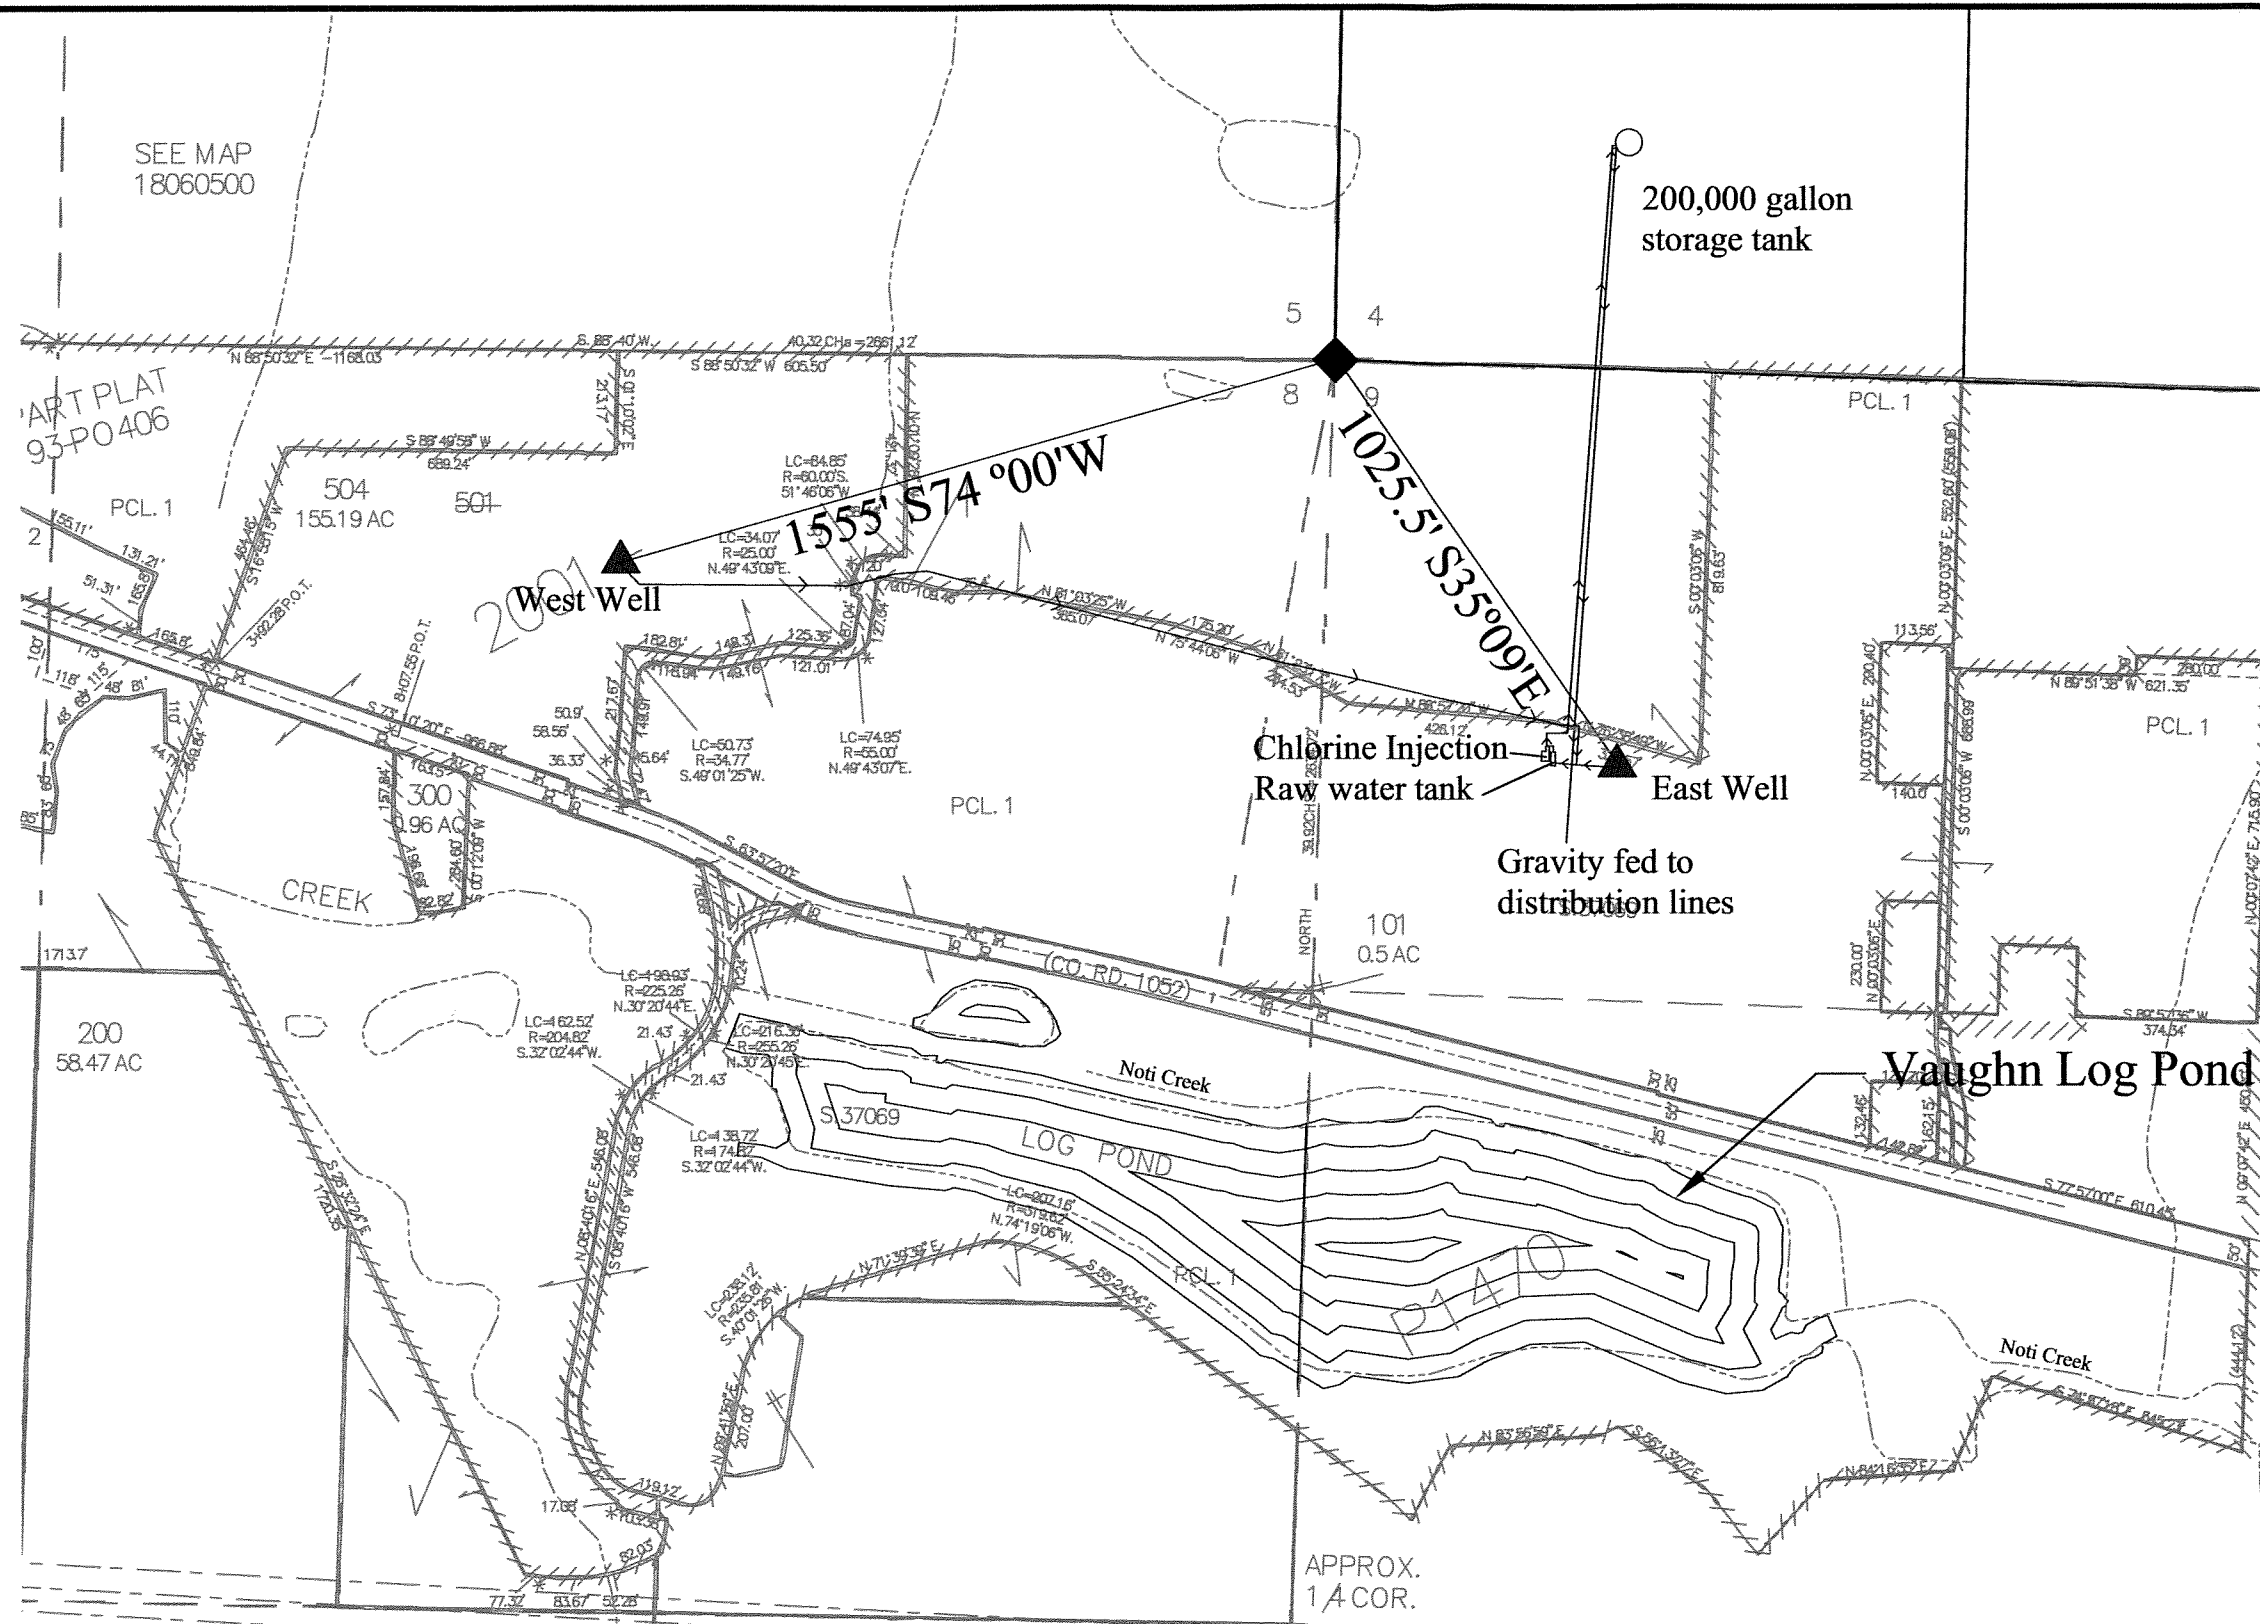

COBU MAP # 0462