


T4N, R28E, S16 WM
UMATILLA COUNTY




1 in = 400 ft


● POD is pump station located in the SW/4, SW/4, Section 16, T4N, R28E, WM, at a distance 660 feet North and 10 feet East from the SW Corner of Section 16 (30 hp turbine pump).

--- WATER CONVEYANCE
Water is conveyed with 8-inch buried steel mainline. Water is applied to alfalfa with center pivot equipped with Nelson D3000 sprayheads on drop tubes. Water is applied to pasture with portable handline and Big Guns.

 PLACE OF USE is 10.9 acres formerly a portion of Certificate 2554:
3.5 acres in NW/4, SW/4, Section 16
7.4 acres in SW/4, SW/4, Section 16 including portions of Tax Lots 2000 and 2100. Currently growing alfalfa hay.

 PLACE OF USE is 15.8 acres formerly a portion of Certificate 55323:
15.8 acres in SW/4, SW/4, Section 16 including portions of Tax Lots 2000 and 2001. Currently growing grass pasture.

The purpose of this map is to identify the location of a water right. It is not intended to provide information regarding the location of property ownership boundary lines.

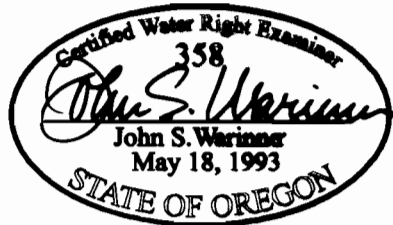

FOUNTAINHEAD
1860 Blue Creek Road
Walla Walla, WA 99362
Phone: 509.529.2646
Fax: 509.522.5251

FINAL PROOF SURVEY MAP
Transfer 8322
in the name of
Norma Quick
78614 Quick Road
Hermiston, OR 97838

Revised by John Warinner 27 APR 2006