


T.8N.,R.4W.,W.M.  
SECTION 35  
COLUMBIA COUNTY, OREGON

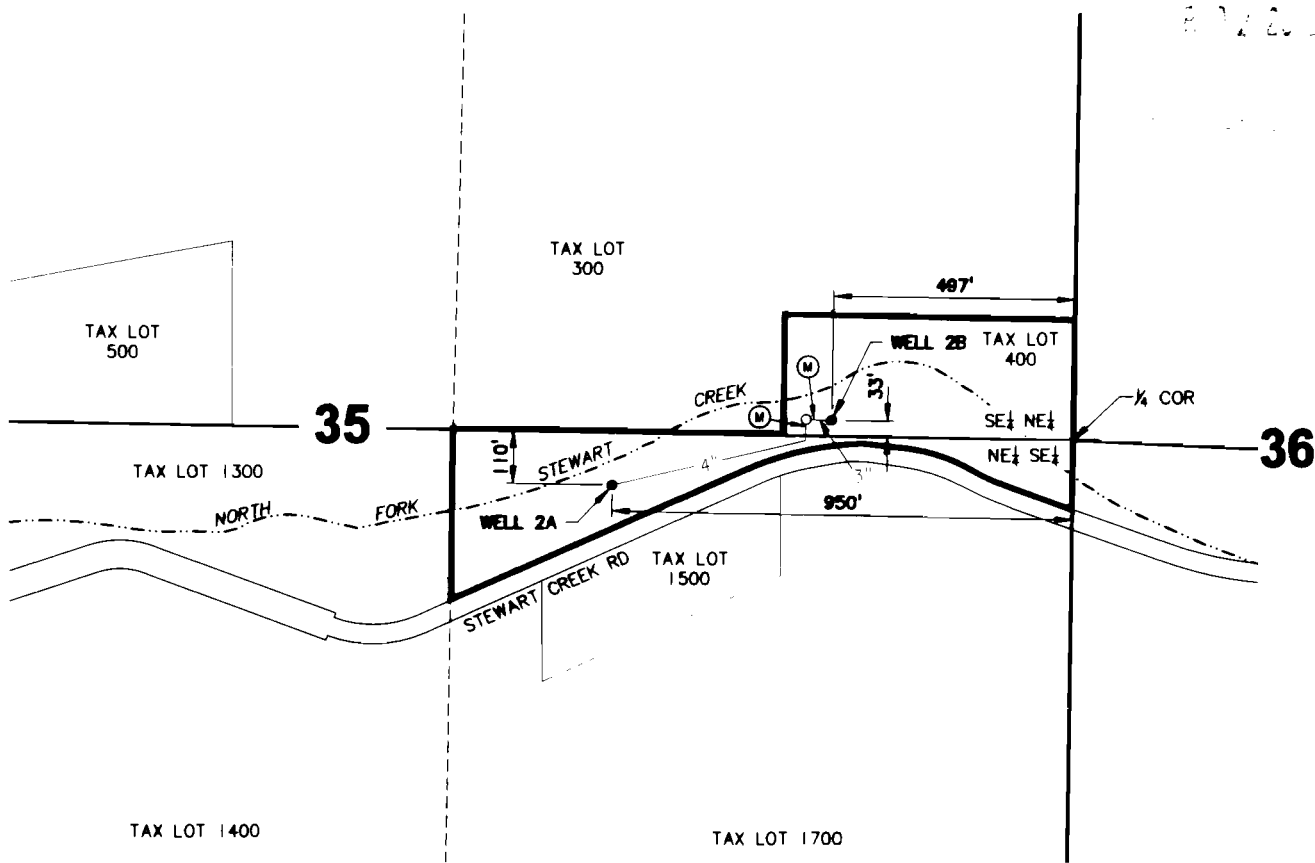

SCALE:  
1"=400'

**LEGEND**

- SECTION LINE
- 1/4 SECTION LINE
- - - 1/4 1/4 SECTION LINE
- QUINCY WATER ASSOCIATION PROPERTY
- WELL
- - - CREEK
- RESERVOIR
- + PIPELINES
- Ⓜ METERS




EXPIRES 6/30/14

**CLAIM OF BENEFICIAL USE MAP  
FOR WATER RIGHT TRANSFER T-11024  
IN THE NAME OF  
QUINCY WATER ASSOCIATION  
COLUMBIA COUNTY, OREGON  
MARCH 2013**

**NOTE: This map is for the purpose of identifying the location of the water right only and is not intended to provide legal dimensions or locations of property lines.**

760

T.7N. & T.8N., R.4W., W.M.  
COLUMBIA COUNTY, OREGON

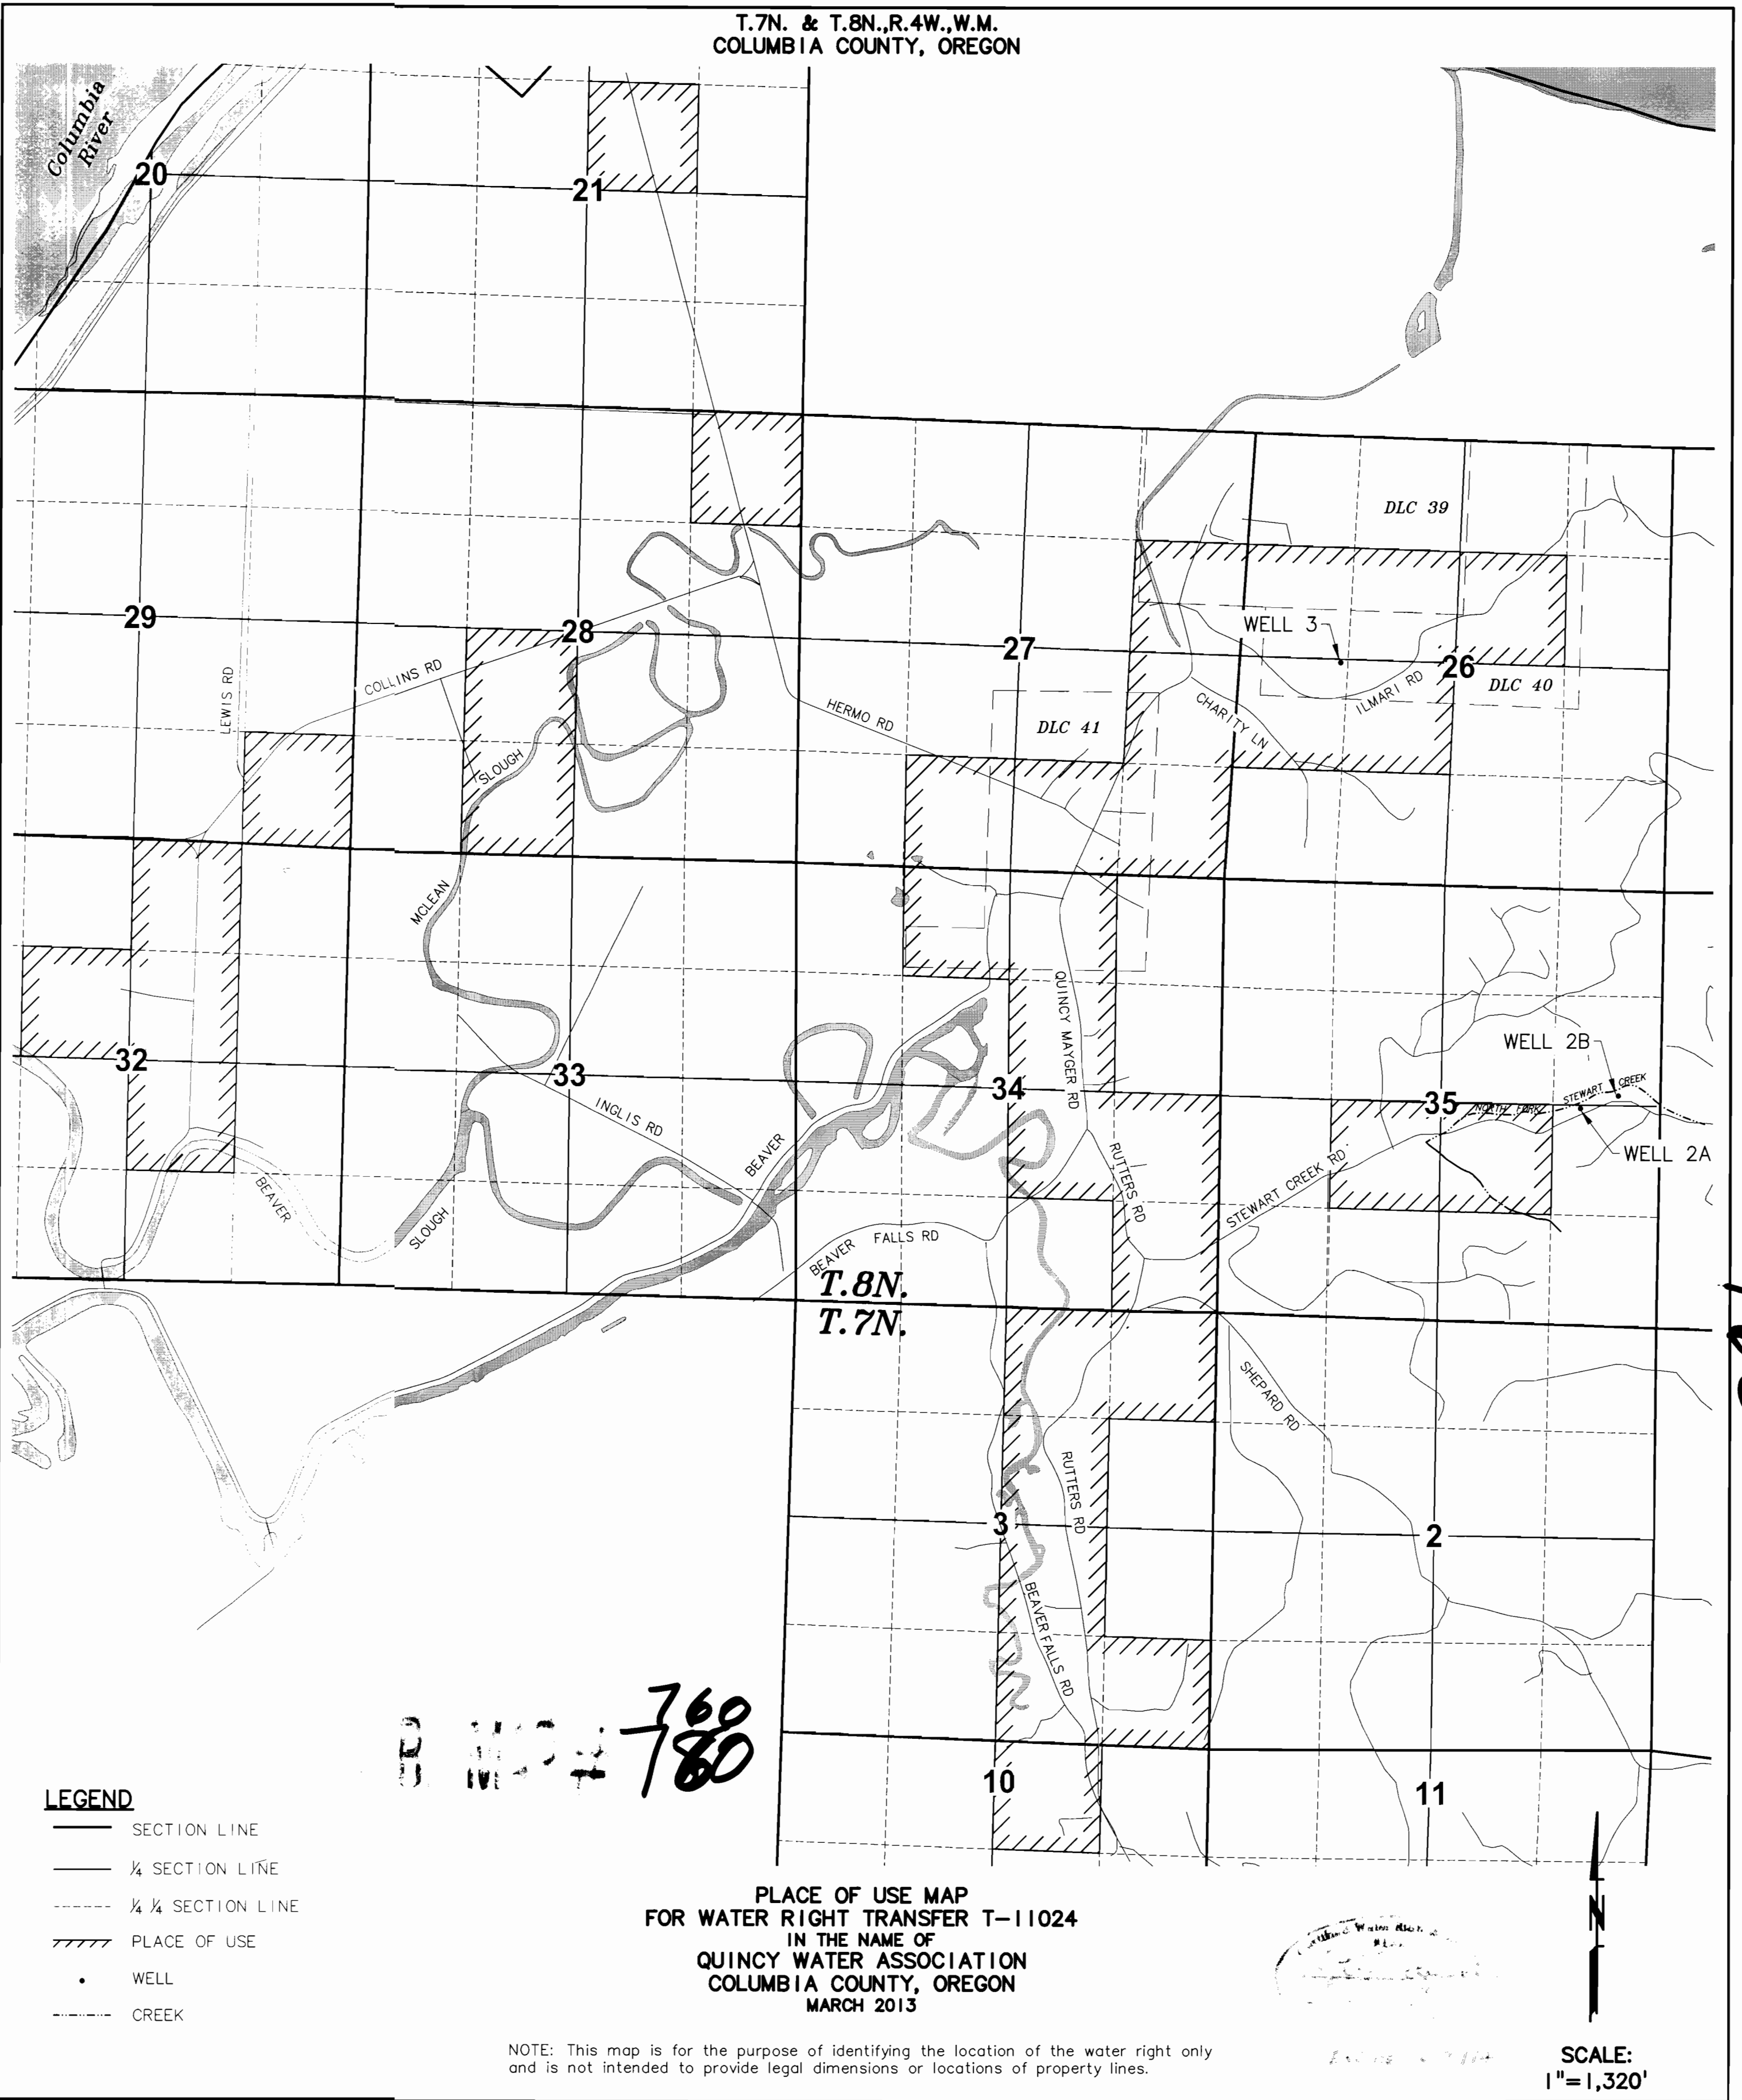

- LEGEND**
- SECTION LINE
  - ¼ SECTION LINE
  - ¼ ¼ SECTION LINE
  - //// PLACE OF USE
  - WELL
  - CREEK

PLACE OF USE MAP  
FOR WATER RIGHT TRANSFER T-11024  
IN THE NAME OF  
QUINCY WATER ASSOCIATION  
COLUMBIA COUNTY, OREGON  
MARCH 2013

NOTE: This map is for the purpose of identifying the location of the water right only and is not intended to provide legal dimensions or locations of property lines.

SCALE:  
1"=1,320'

G:\PDX\_Projects\101155\CAD\SHEETS\10-1155-501-OR-POU MAP.dwg, 3/20/2013 11:07 AM DAK (LMS Tech)

760