


T.5 & 6N. R.35E., W.M

RECEIVED

DEC 10 1998

**WATER RESOURCES DEPT.
SALEM, OREGON**

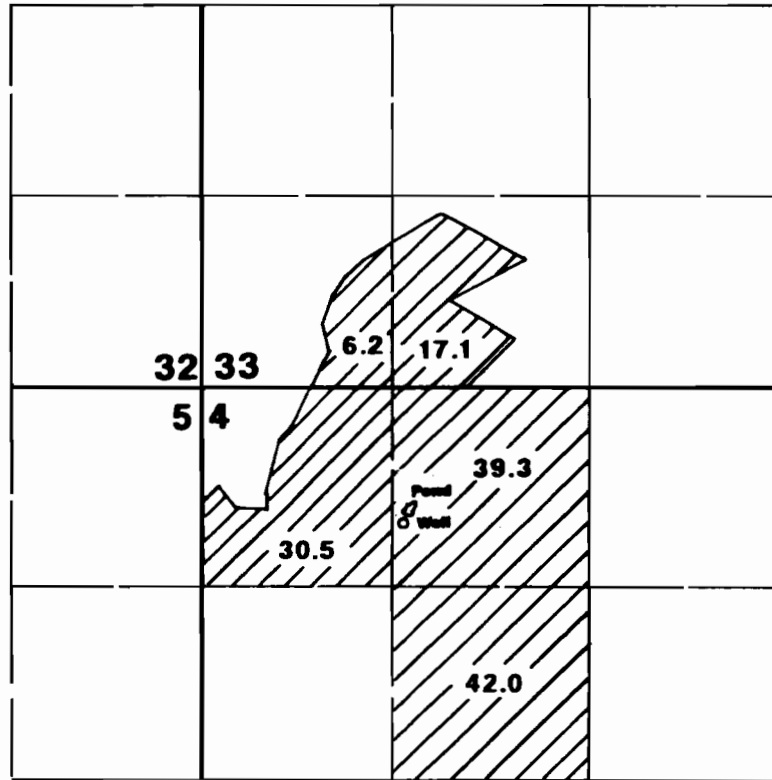

Well is located 1710'N & 1285'W from the center of Section 4.

Final Proof Survey

Application #: G-14243 Permit #: G-13010

In Name Of

Pepper Bridge Land Co.

Surveyed on September 12, 1998 by James Grimm

This Map Was Prepared For The Purpose Of Identifying The Location Of A Water Right Only And Is Not Intended To Provide Legal Dimensions Or Location Of Property Ownership Lines.

