

Correction Map of


ENTERPRISE DITCH

SEPT. 1, 1924

SCALE 2"=1 Mile

T. 41 S., R. 7 W., W.M.

T. 41 S., R. 6 W. W.M.

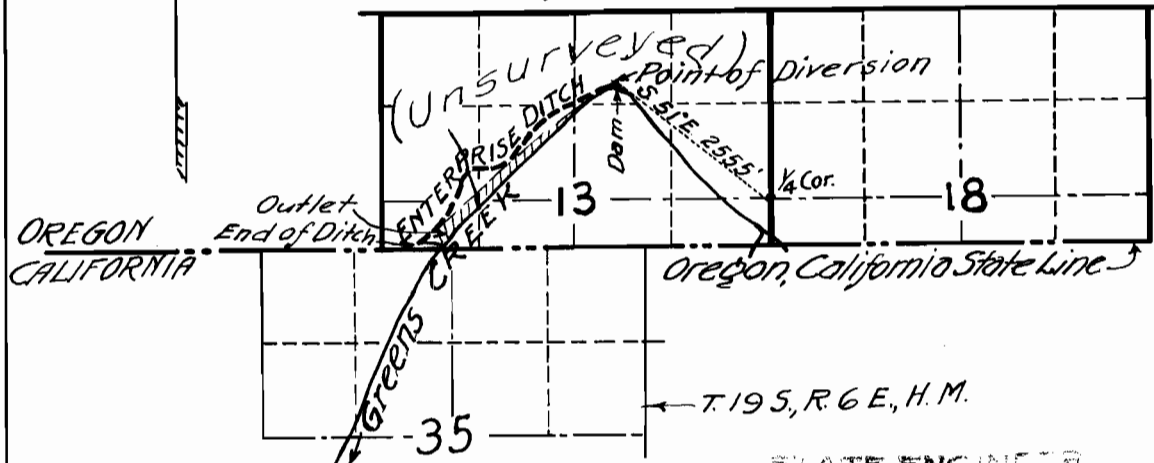

STATE ENGINEER
RECEIVED

Certificate of Surveyor.

I, Tom R. Pearce, of Grants Pass, Oregon, do hereby certify that this map was made from notes taken during an actual survey made under my direction on Aug 28, 1924, and that it correctly represents the work described in the accompanying application together with the location of streams and other ditches in the immediate vicinity.

Tom R. Pearce,
Surveyor

By C. D. Cameron.

838

Application No. 9058

Parcel No. 6538