
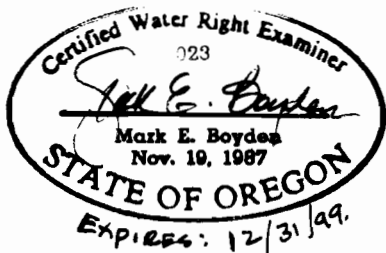


T. 39 S., R. 1 E., W. M.  
(TRANSFER POINT OF DIVERSION)

**RECEIVED**

SEP 20 1999

WATER RESOURCES DEPT  
SALEM, OREGON

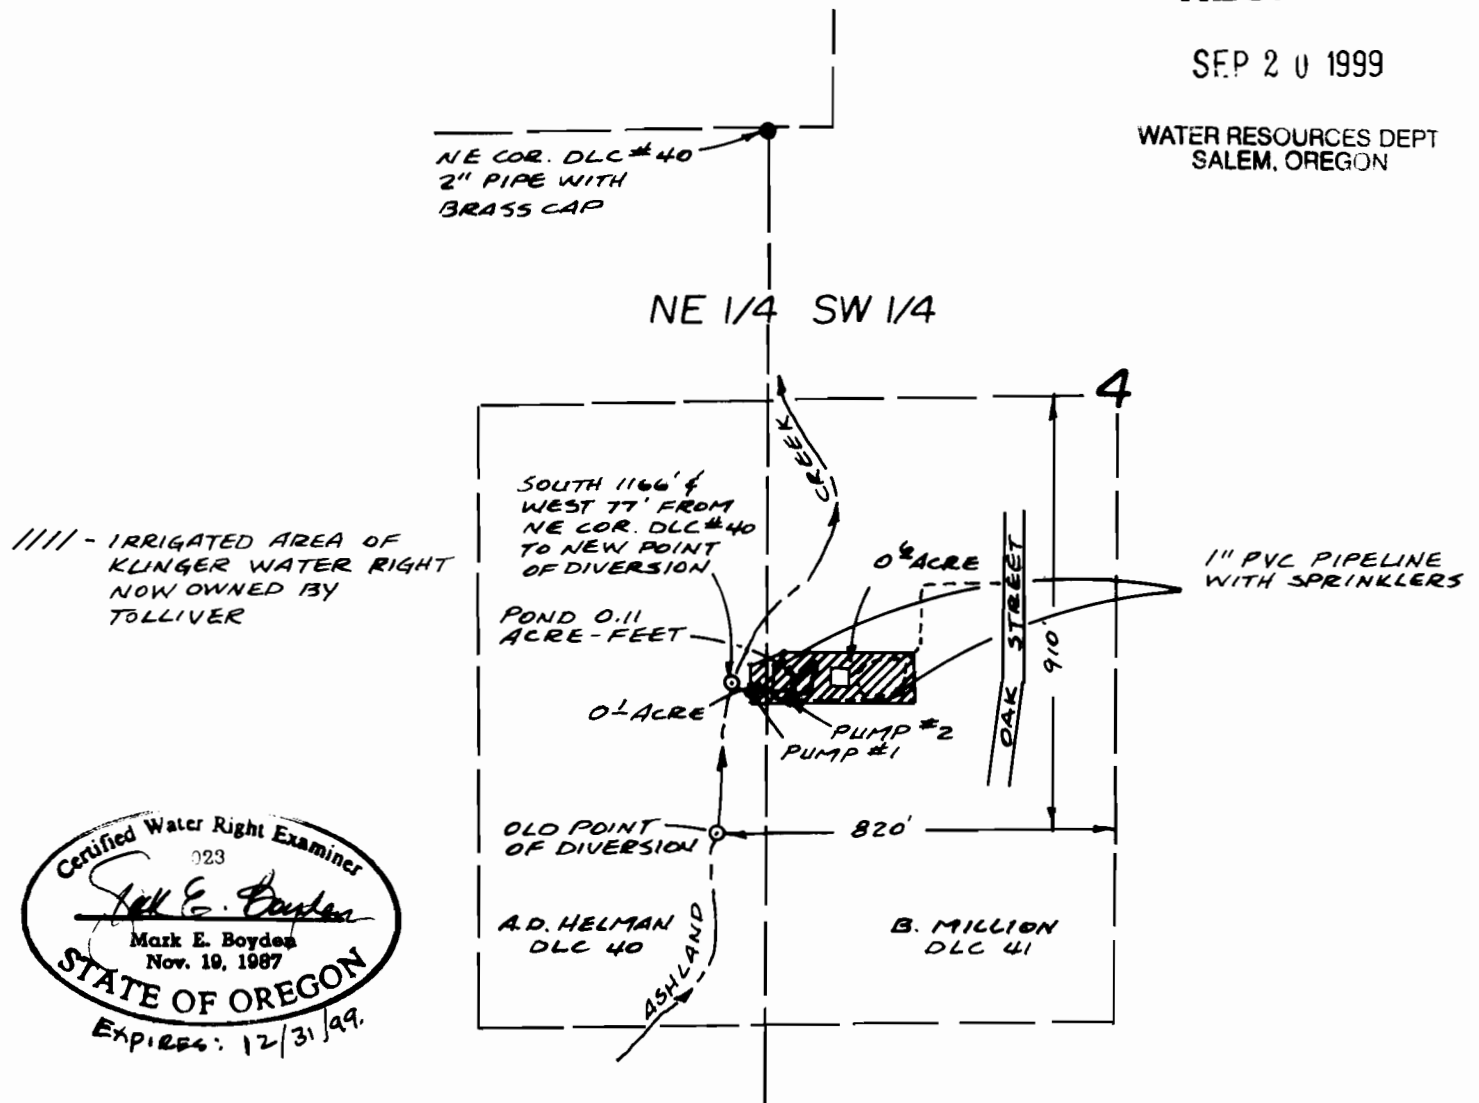

**TRANSFER APPLICATION MAP**

CERTIFICATE NO. T-7746

APPLICANT: HOWARD A. TOLLIVER  
779 OAK ST.  
ASHLAND, OR. 97520

NOTE: THIS MAP IS NOT TO BE  
UTILIZED FOR BOUNDARY SURVEYS



SCALE: 1" = 400'