


Claim of Beneficial Use

T-10076



in the name of Rachel and Thomas Harpham

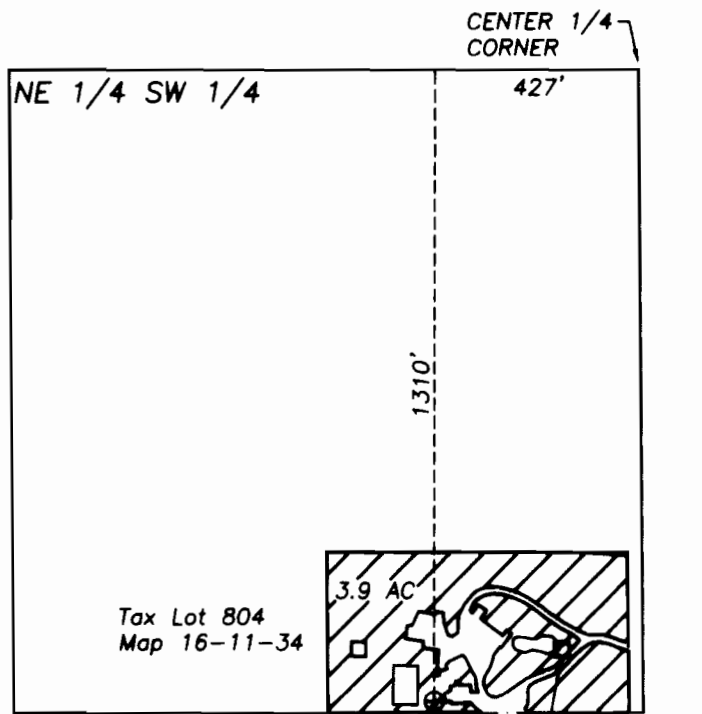

Section 34
T16S, R11E, W.M.
Deschutes Co., OR



Area beneficially irrigated under transfer
T-10076 (Special Order Volume 69, Page 44),
priority date August 31, 1992.

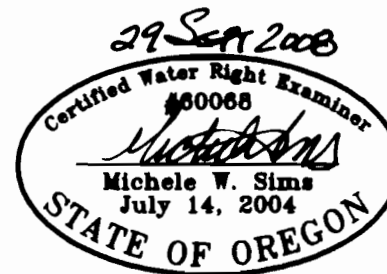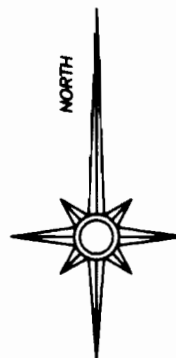

Renewal date: 6/30/2010

RECEIVED

OCT 03 2008

WATER RESOURCES DEPT.
SALEM, OREGON

400 0 400 800 1200



GRAPHIC SCALE - FEET

THIS MAP IS FOR THE PURPOSE OF IDENTIFYING THE LOCATION OF THE
WATER RIGHT. IT IS NOT INTENDED TO PROVIDE LEGAL DIMENSIONS OR
LOCATIONS OF PROPERTY OWNERSHIP LINES.