


Township 5 North, Range 29 East, W.M.
NW 1/4 SW 1/4 of Section 31
UMATILLA COUNTY

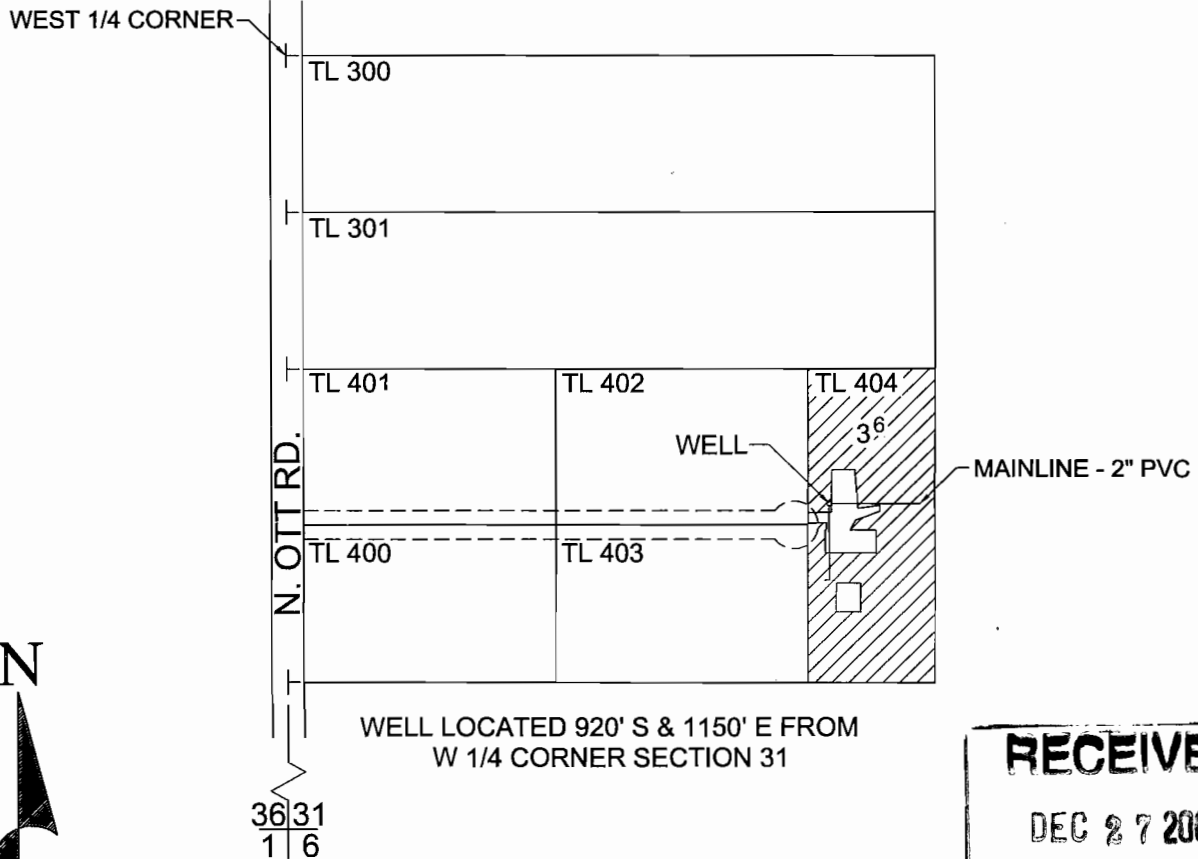

RECEIVED
DEC 27 2004
WATER RESOURCES DEPT
SALEM, OREGON

Certified Water Rights Examiner
57194WRB
Paul L. Wattenburger
Paul L. Wattenburger
July 16, 2003
STATE OF OREGON

EXPIRES: 6/30/06

FINAL PROOF SURVEY
under
Transfer Application No. T-8848
Permit No. G-7357
in names of
DENNIS E. AND KAREN A. BAKER
October 8, 2004

THIS MAP WAS PREPARED FOR THE PURPOSE OF IDENTIFYING THE LOCATION OF A WATER RIGHT ONLY AND IS NOT INTENDED TO PROVIDE LEGAL DIMENSIONS OR LOCATION OF PROPERTY OWNERSHIP LINES.