

Transfer

Sheet 1 of 1


FROM
E 1/2

TO
E 1/2


T.2N, R.32E, W.M.

SEC. 22

SEC. 22

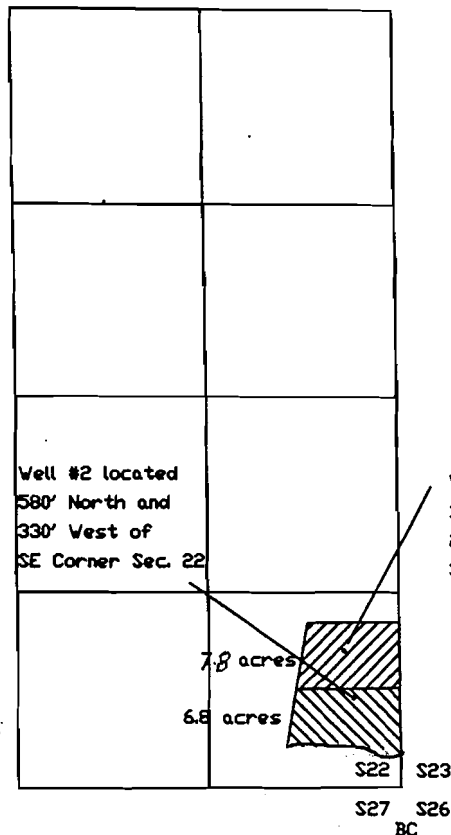


Permit G-5728
Application G-5963
14.6 acres
Well #1 located
1000' North and
220' West of
SE Corner Sec. 22

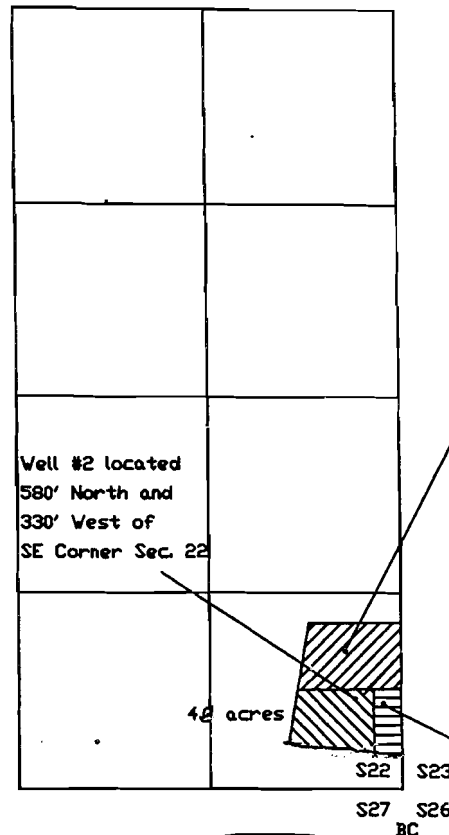

Permit G-5728
Application G-5963
14.6 acres
Well #1 located
1000' North and
220' West of
SE Corner Sec. 22

2.0 acres
Well #3 located
563' North and
167' West of
SE Corner Sec. 22

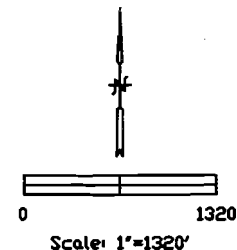

T-8415


RECEIVED

JAN 11 2000

**WATER RESOURCES DEPT.
SALEM, OREGON**

OWNER:
Vicky Thurman
602 NW Tenth Street
Pendleton, OR 97801
(541) 278-2891

Survey By:
CWRE 300
(renews 6-30-99)
David Haddock
P. O. Box 1574
Pendleton, OR 97801
(541) 276-2174
May 25, 1999
Revised May 31, 1999

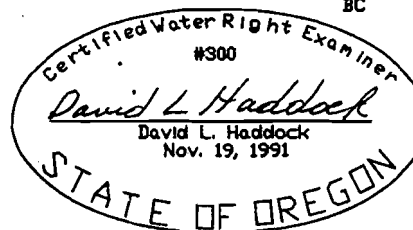


NOTE:
The information shown
on this map is solely
for Water Rights
purposes. The data
shown does not represent
ownership information.

Sheet 1 of 1 centerline
Earlley Lane


FINAL PROOF SURVEY

0.21 ac. irrigated
with underground
sprinkler system

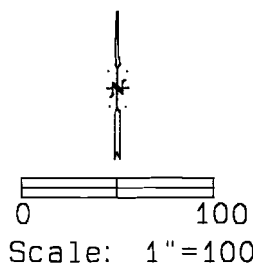

0.27 ac. irrigated
with underground
sprinkler system

NOTE:
The information shown
on this map is solely
for water rights
purposes. The data
shown does not
represent ownership
information.

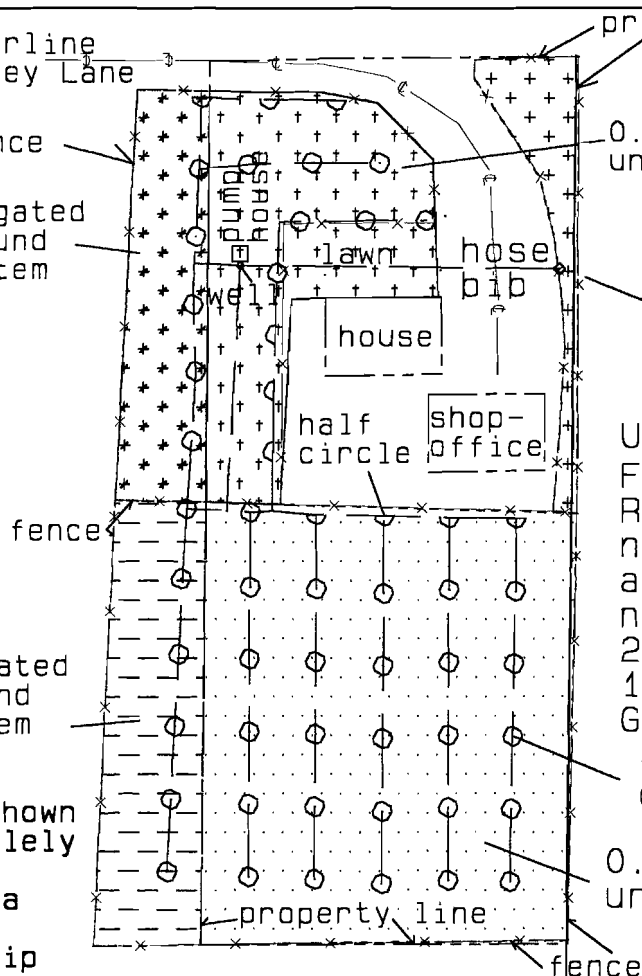


0.37 ac. irrigated with
underground sprinkler system

0.10 ac. irrigated with
hose and movable sprinkler

UNDERGROUND SPRINKLER SYSTEM
Full circle sprinklers are
Rainbird 5000 with 5/32"
nozzles. Half circle sprinklers
are Rainbird 5000 with 7/64"
nozzles. The mainline pipe is
2" pvc. Distribution lines are
1 1/2" pvc. Pump is a 5 HP
Goulds submersible.

full
circle

0.99 ac. irrigated with
underground sprinkler system

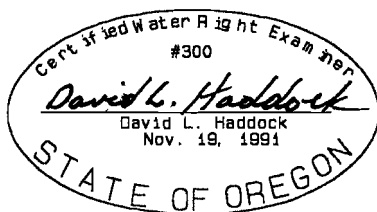

(renews 6-30-01)

T. 2 N., S22 S23
R. 32 E., S27 S26
W. M.

Survey Date: April 21, 2001

SURVEY FOR
Vicky Thurman
43786 Earlley Lane
Pendleton, OR 97801
(541) 276-8233

David L. Haddock, Surveyor and Engineer
P.O. Box 1574
Pendleton, Oregon 97801
(541) 276-2174

HADDOCK SURVEYING

**GPS
AND
TOTAL STATION**

WATER RESOURCES DEPT
SALEM, OREGON

MAY 09 2001

RECEIVED