


T. 16 S. R. 4 W. W.M.

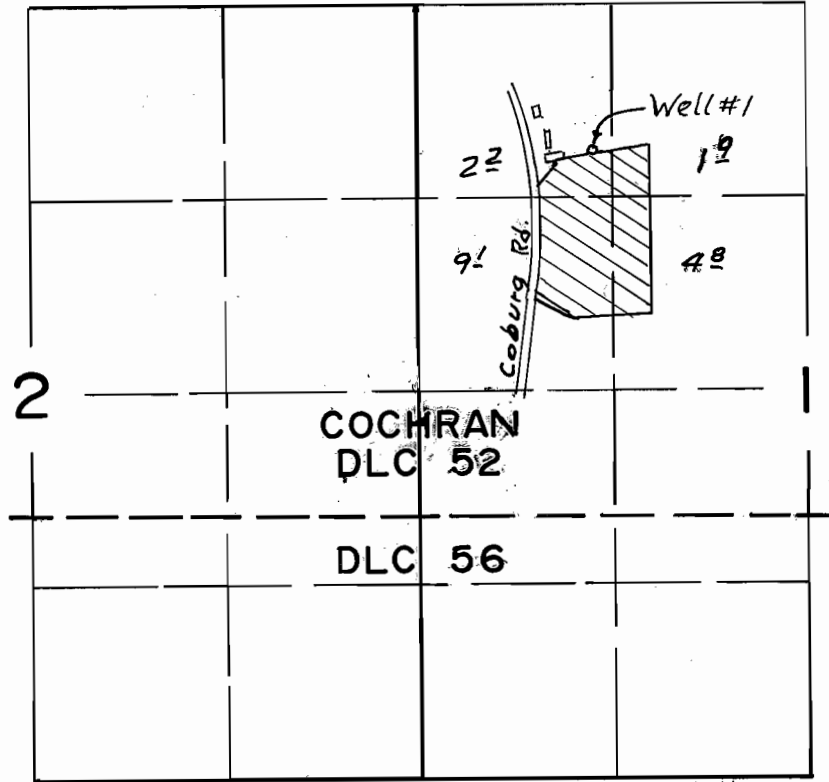

4" = 1 Mi.

Well #1 loc. 1010'S & 1170'E from NW cor. Sec. 1

RECEIVED

SEP 11 2000

WATER RESOURCES DEPT.  
SALEM, OREGON

FINAL PROOF SURVEY  
UNDER


T-7232 *deb*

TRANSFER NO. ~~T-7273~~

Application No. .... Permit No. ....

IN NAME OF

HAYWORTH FARMS, INC.

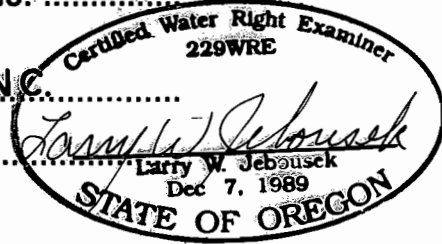

Surveyed Aug. 15, 2000, by .....

THIS MAP WAS PREPARED FOR THE PURPOSE OF IDENTIFYING THE LOCATION OF A WATER RIGHT ONLY AND IS NOT INTENDED TO PROVIDE LEGAL DIMENSIONS OR LOCATION OF PROPERTY OWNERSHIP LINES.