



CLAIM OF BENEFICIAL USE MAP
Section 11, T.26S. R.16E., W.M.

Lake County, Oregon


T-8283

Dennis Mauney

SCALE

1" = 1320'

Tax Lot 3400

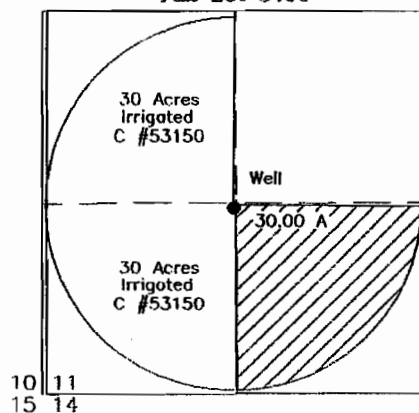

Point of beginning of survey is
1/2" right-of-way pin located 30'
East of Section Corner.


P.O.A. is located North 1300' and
East 1290' from the SW Section
Corner Section 11

RECEIVED

AUG 27 2001

**WATER RESOURCES DEPT.
SALEM, OREGON**

Survey by: Sundet & Associates
P.O. Box 122B
Lakeview, OR 97630
541-947-3293
June 2001 Dr #13101

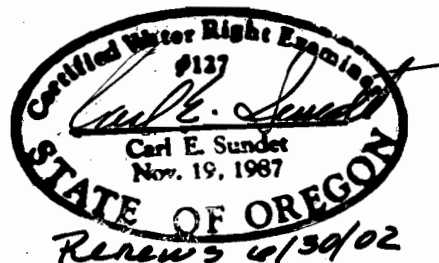

This map is for the purpose of identifying the location of the
Water Right only and is not intended to provide legal dimensions
or location of property ownership lines.