


**W/2 of NE/4 of SEC 24
T6N, R35E, WM
Umatilla County**

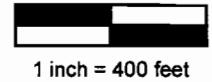

- ⊙ **Point of Diversion (Authorized)**
 POD 1 located in the SE/4 NE/4, Section 24, 1660 feet S and 1360 feet E from N/4 Corner of Section 24.

 POD 2 located in the NE/4 NE/4, Section 24, 915 feet S and 1420 feet E from N/4 Corner of Section 24.

- ⊕ **Point of Appropriation (Proposed)**
 POA 1 is groundwater well (alluvial aquifer) located in the NW/4 NE/4 of Section 24, 1260 feet S and 720 feet E from N/4 Corner of Section 24. Well Log UMAT 4461. Used since 1987 (23 yrs).

Place of Use (Included)
 6.8 acres in SW NE of Section 24 (TL 400)


Place of Use (Not Included)
 18.06 acres, including:
 11.06 acres in SW NE of Section 24
 7.0 acres in NW SE of Section 24

OCT 14 2010

The purpose of this map is to identify the location of a water right. It is not intended to provide information regarding the location of property boundary lines.

FOUNTAINHEAD
 1204 Alvarado Terrace
 Walla Walla, WA 99362
 509.529.2646 phone

T 11144

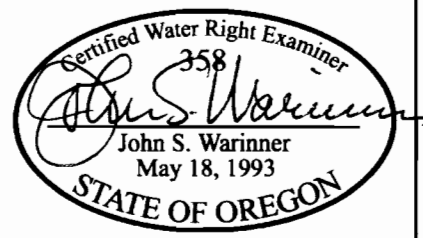

**TRANSFER MAP
 POD to Historic POA
 Certificate 80904**

 in the name of
 DALE WOOD

 Revised 14 JUL 2010