


T. 6. N. R. 35 & 36 E. W. M.

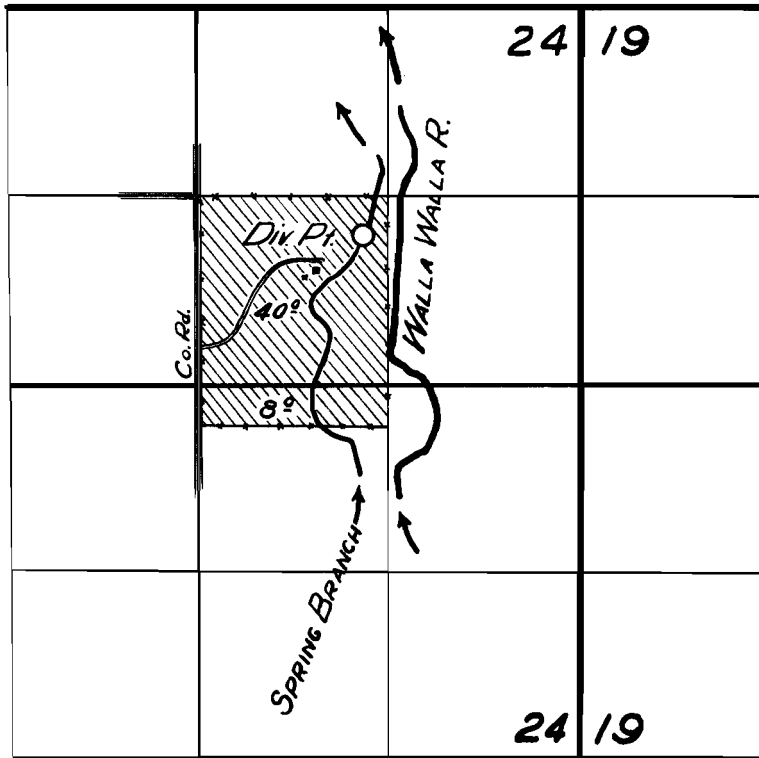


FINAL PROOF SURVEY
UNDER


Application No. 24507 Parcel No. 19303
IN NAME OF

WILLIAM & CHARLOTTE NEELEY

Surveyed 6 Nov. 1955, by *[Signature]*

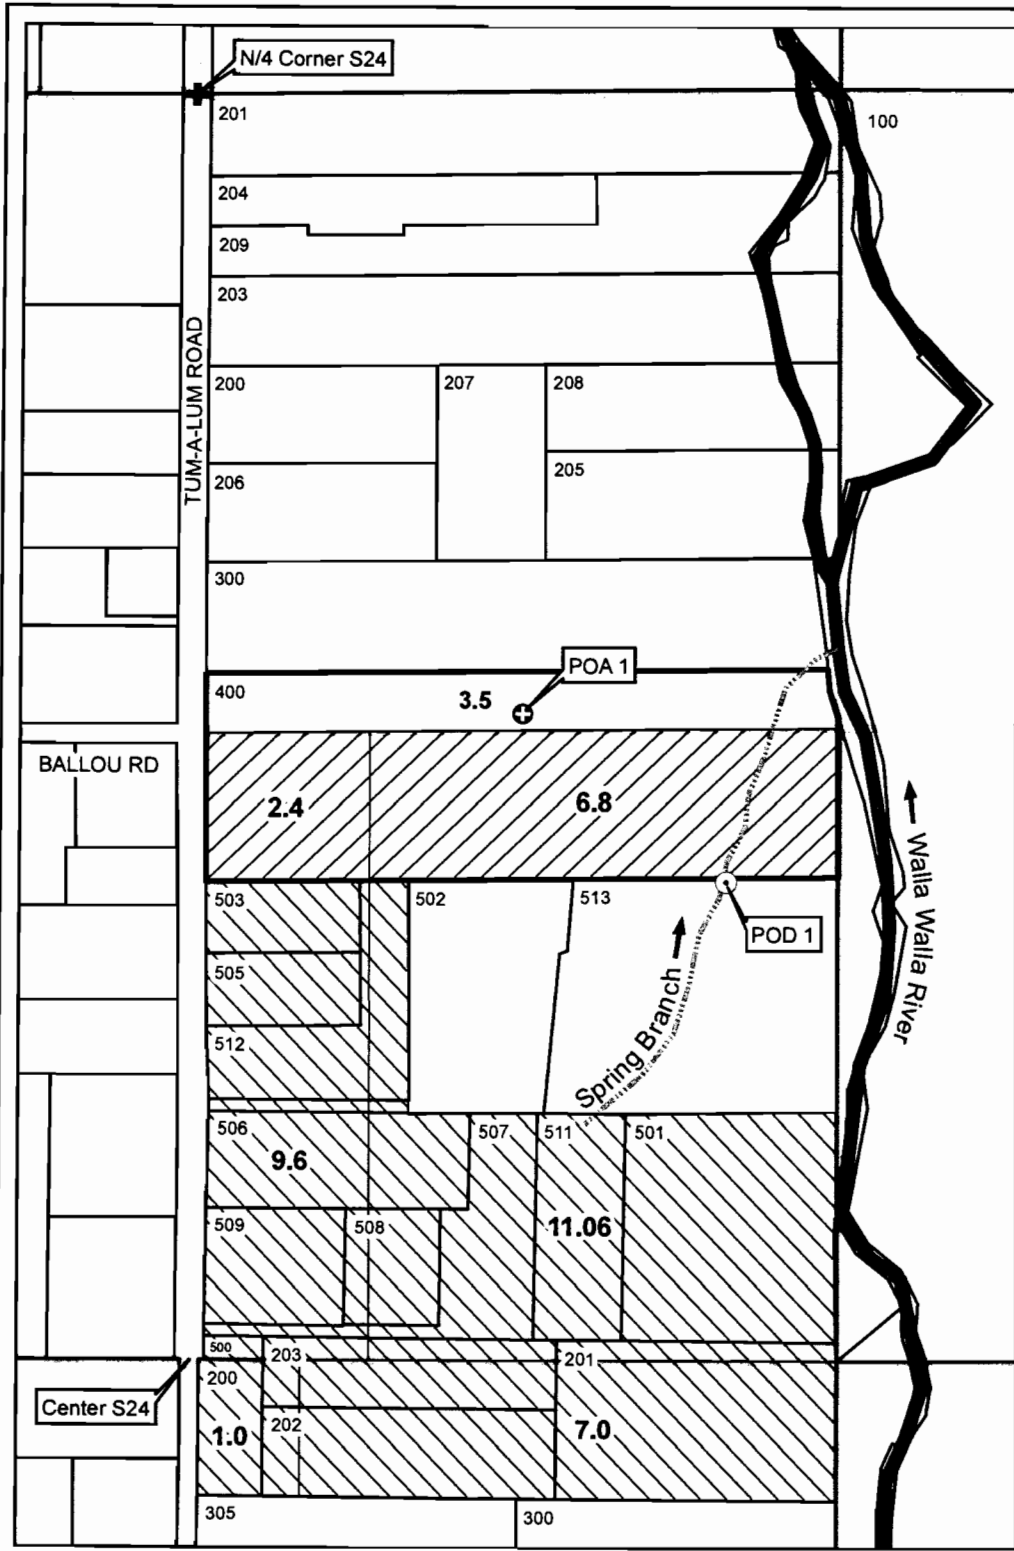

**W/2 of NE/4 of SEC 24
T6N, R35E, WM
Umatilla County**

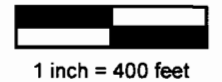

- ⊙ **Point of Diversion (Authorized)**
POD 1 located in the SE/4 NE/4, Section 24, 325 feet S and 227 feet W from NE Corner of SW/4 NE/4 of Section 24.
- ⊕ **Point of Appropriation (Proposed)**
POA 1 is groundwater well (alluvial aquifer) located in the NW/4 NE/4 of Section 24, 1260 feet S and 720 feet E from N/4 Corner of Section 24. Well Log UMAT 4461. Used since 1987 (23 yrs).

Place of Use (Included)
2.4 acres in SW NE of Section 24 (TL 400) - PRIMARY
6.8 acres in SW NE of Section 24 (TL 400) - SUPPLEMENTAL


Place of Use (Not Included)
9.6 acres in SW NE of Section 24 - PRIMARY
11.06 acres in SW NE of Section 24 - SUPPLEMENTAL
1.0 acre in NW SE of Section 24 - PRIMARY
7.0 acres in NW SE of Section 24 - SUPPLEMENTAL

OCT 14 2010

The purpose of this map is to identify the location of a water right. It is not intended to provide information regarding the location of property boundary lines.

FOUNTAINHEAD
1204 Alvarado Terrace
Walla Walla, WA 99362
509.529.2646 phone

11144

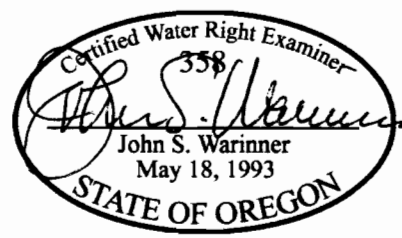

**TRANSFER MAP
POD to Historic POA
Certificate 80905**
in the name of
DALE WOOD
Revised 14 JUL 2010