


CLAIM OF BENEFICIAL USE MAP—TRANSFER T-8949
 NE1/4NE1/4, SEC. 4, T.39S., R.3W., W.M.
 JACKSON COUNTY, OREGON
 FOR
 PATRICK AND JANE HENRY
 407 HAMILTON ROAD
 JACKSONVILLE, OREGON 97530

RECEIVED BY OWRD

NOV 30 2012

SALEM, OR

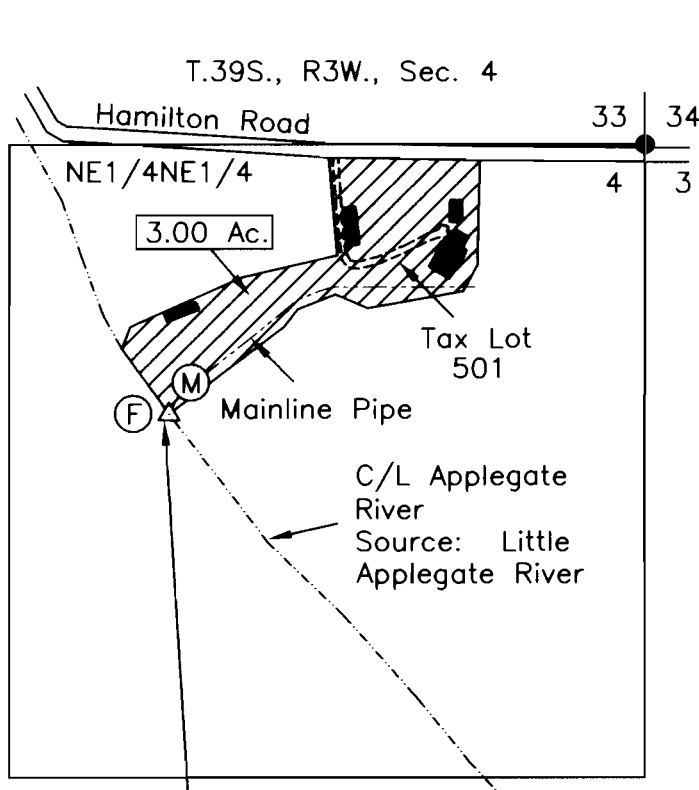

Scale: 1"=400'
 Date: October 24, 2012

LEGEND

- Found Survey Monument
- Denotes Building
- (M) Denotes Flow Meter
- (F) Denotes Fish Screen
- Denotes Mainline Pipe
- ▨ Denotes Area Under Certificate No. 81415, Priority Date Sept. 1, 1857 (Ref: Remaining Right Certificate No. 81415)

Point of Diversion No. 1:
 488' South and 913' West
 from NE Corner Sec. 4.
 Fish Screen at Pump Intake

Little Applegate River
 (Location Approx.)

Applegate River
 (Location Approx.)



This map was prepared for the purpose of identifying the location of a water right only and is not intended to provide legal dimensions or location of property ownership.

HAROLD L. CENTER
 2604 David Lane
 Medford, OR. 97504
 Phone 541-535-6108
 Oregon Certificate No. 152
 Cert. Renewal Date: 12/31/2013

Project: 12-18 Henry