


FINAL PROOF MAP
for CHANGE IN POINT OF DIVERSION
in the name of CANDUS D. & RONALD DALESKY
located in the NW 1/4 of the SW 1/4 of Section 4
Township 2 North, Range 3 West, Willamette Meridian
Washington County, Oregon

Date : September 9, 2001

Scale : 1" = 400'

TRANSFER NO. T-8062

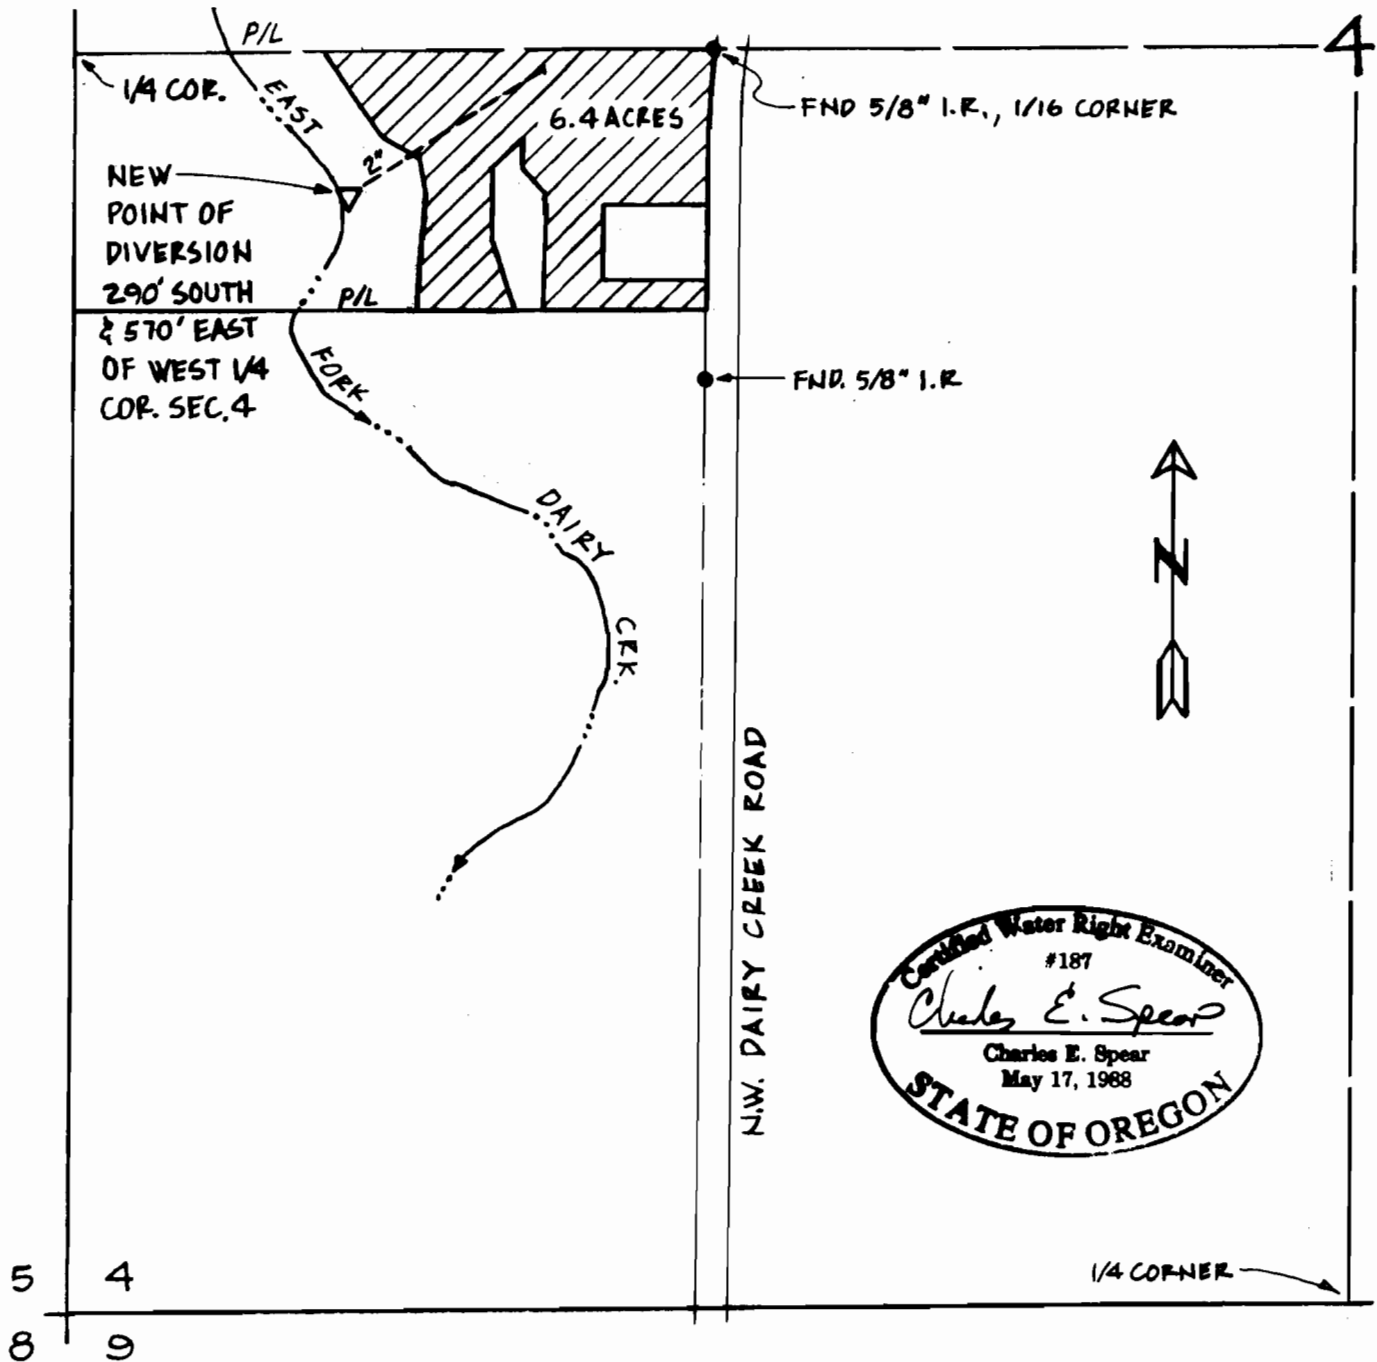

THIS MAP DOES NOT
INTEND TO PROVIDE
DIMENSIONS FOR THE
EXACT LOCATION OF
PROPERTY OR BOUNDARY
LINES.

CHARLES E. SPEAR CWRE 187
831 N.E. BIRCHAIRE LN.
HILLSBORO, OR. 97124
PHONE (503) 648-2879

RECEIVED

SEP 28 2001

WATER RESOURCES DEPT.
SALEM, OREGON

