


CLAIM OF BENEFICIAL USE MAP
FRANKLIN LEON AND BILLIE J. FLICK
CHANGE IN POINT OF DIVERSION
T-10816
SE1/4NW1/4 SEC. 9, T39S, R23E, WM
LAKE COUNTY OREGON

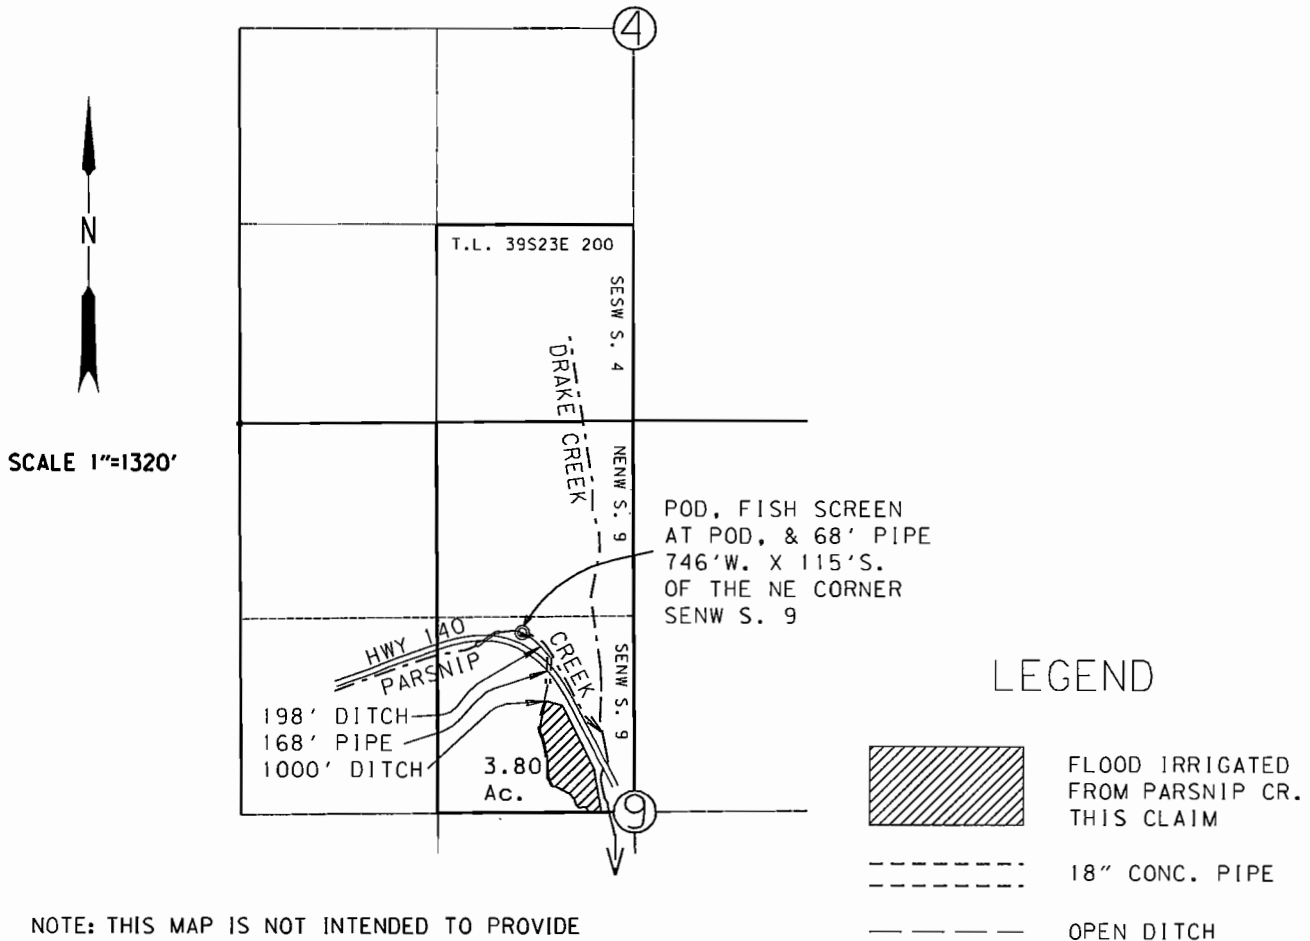


RECEIVED

JUL 02 2012

WATER & SOURCES DEPT
SALEM, OREGON

PREPARED BY:

OREGON DEPT. OF TRANSPORTATION
REGION 4 TECHNICAL CENTER
63085 N. HWY 97, SUITE. 102
BEND, OREGON 97701

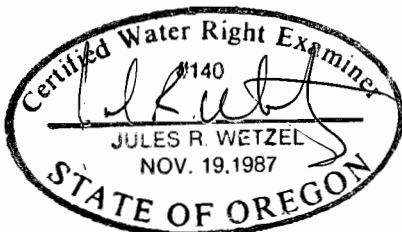

EXPIRES 6/30/14