
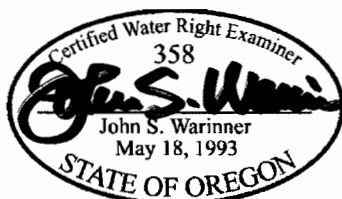


⊙ **Authorized POD**
 Streamflow diversion system including centrifugal pump with fish screen on flexible hose and totalizing flowmeter located 230 feet N and 26 ft E from W/4 Corner of Section 10.

----- **Conveyance**
 1.25-inch mainline feeding a variety of landscape sprinklers mounted on stationary risers and portable garden hoses.

 **Place of Use**
 1.08 acres in SW/NW Section 10, including turf, landscaping and native plant systems.

The purpose of this map is to identify the location of a water right. It is not intended to provide information regarding the location of property ownership boundary lines.



FOUNTAINHEAD
 1860 Blue Creek Road
 Walla Walla, WA 99362
 509.529.2646 phone

CLAIM OF BENEFICIAL USE
Transfer 8587

in the name of
JUSTIN & CHRISTINA BRUNSON

Revised 27 NOV 2007