

T. 35S., R., 3W., W.M

TRANSFER T-9025 POINT of DIVERSION

LEGEND

- ////// IRRIGATED AREA
- ⊙ BLM BRASS CAP
- 5/8" REBAR/AL.CAP
- "BOYDEN PLS 281"
- P/L = PROPERTY LINE





Scale: 1" = 200'

FINAL CORRECTION PROOF SURVEY

FOR: MARIA COOPER
4303 SARDINE CREEK RD
GOLDHILL, OR 97525

CTR. SOUTH
1/16 COR.
SEC. 29

SE 1/4 SW 1/4

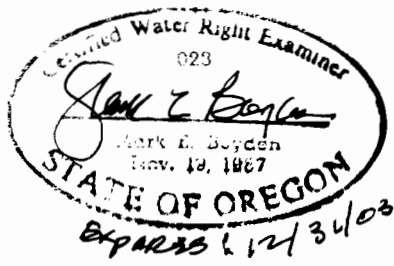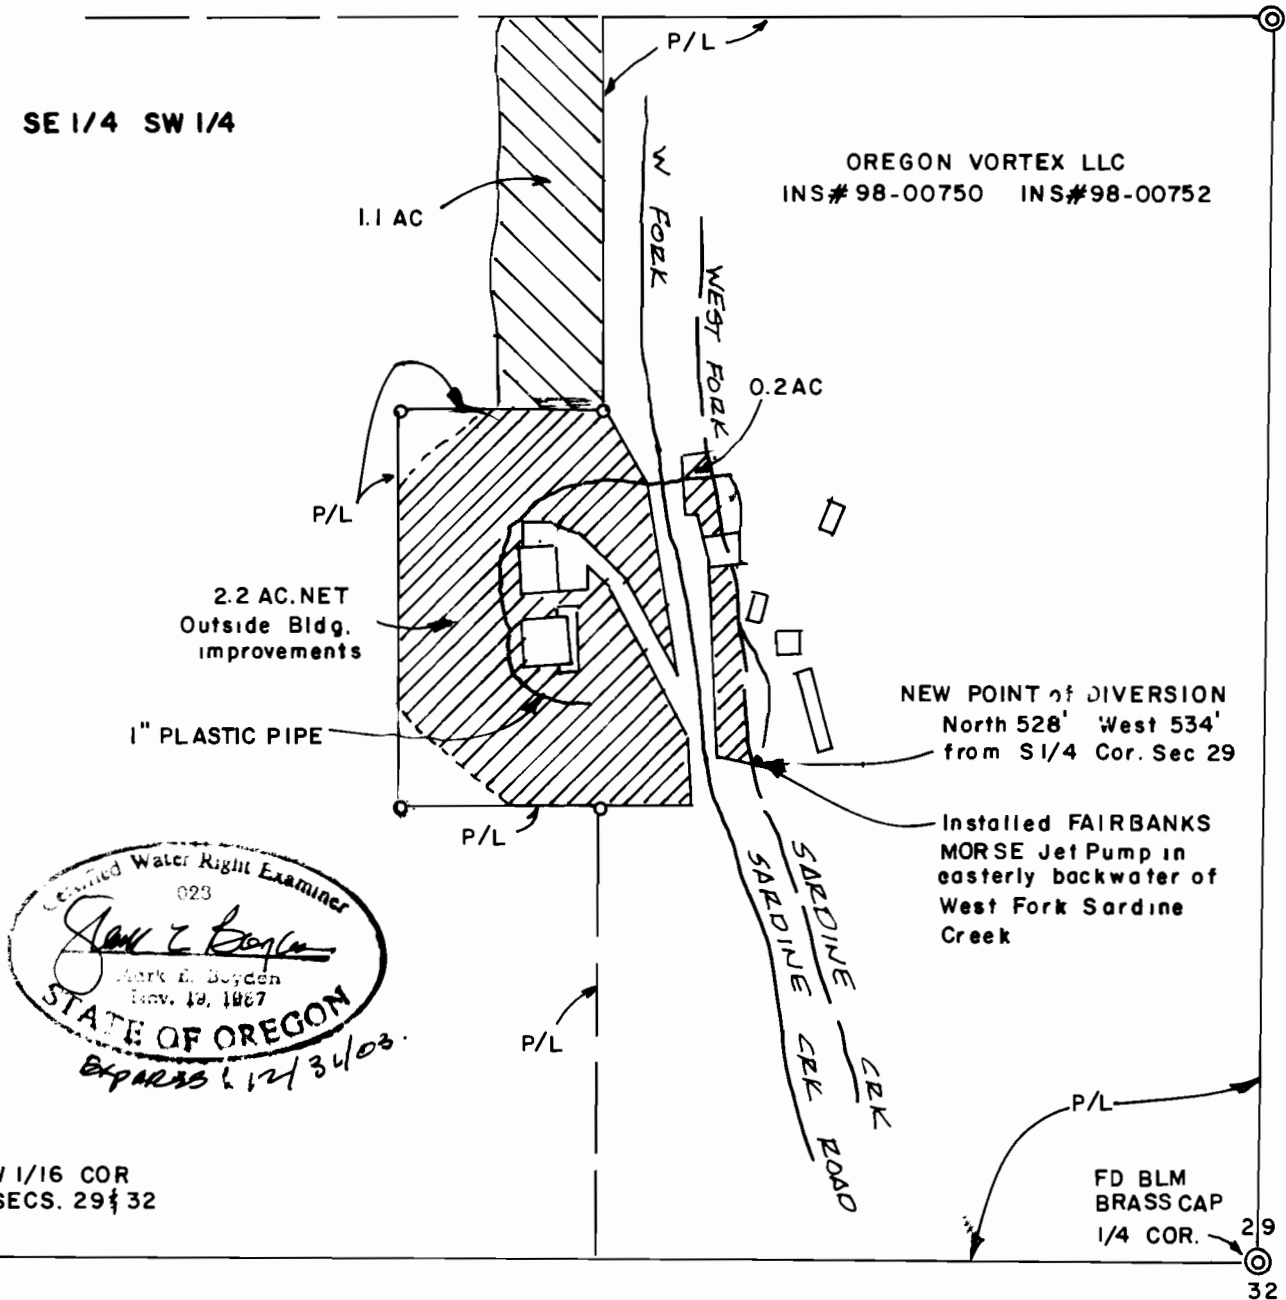

W 1/16 COR
SECS. 29 & 32

FD BLM
BRASS CAP
1/4 COR.

29
32