
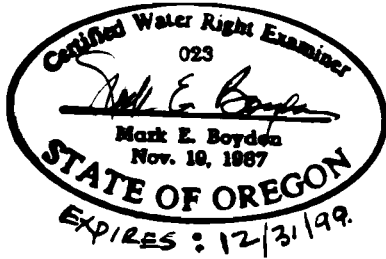


T. 39 S., R. 1 E., W. M.  
 (TRANSFER POINT OF DIVERSION)

**RECEIVED**

SEP 20 1999

WATER RESOURCES DEPT  
 SALEM, OREGON

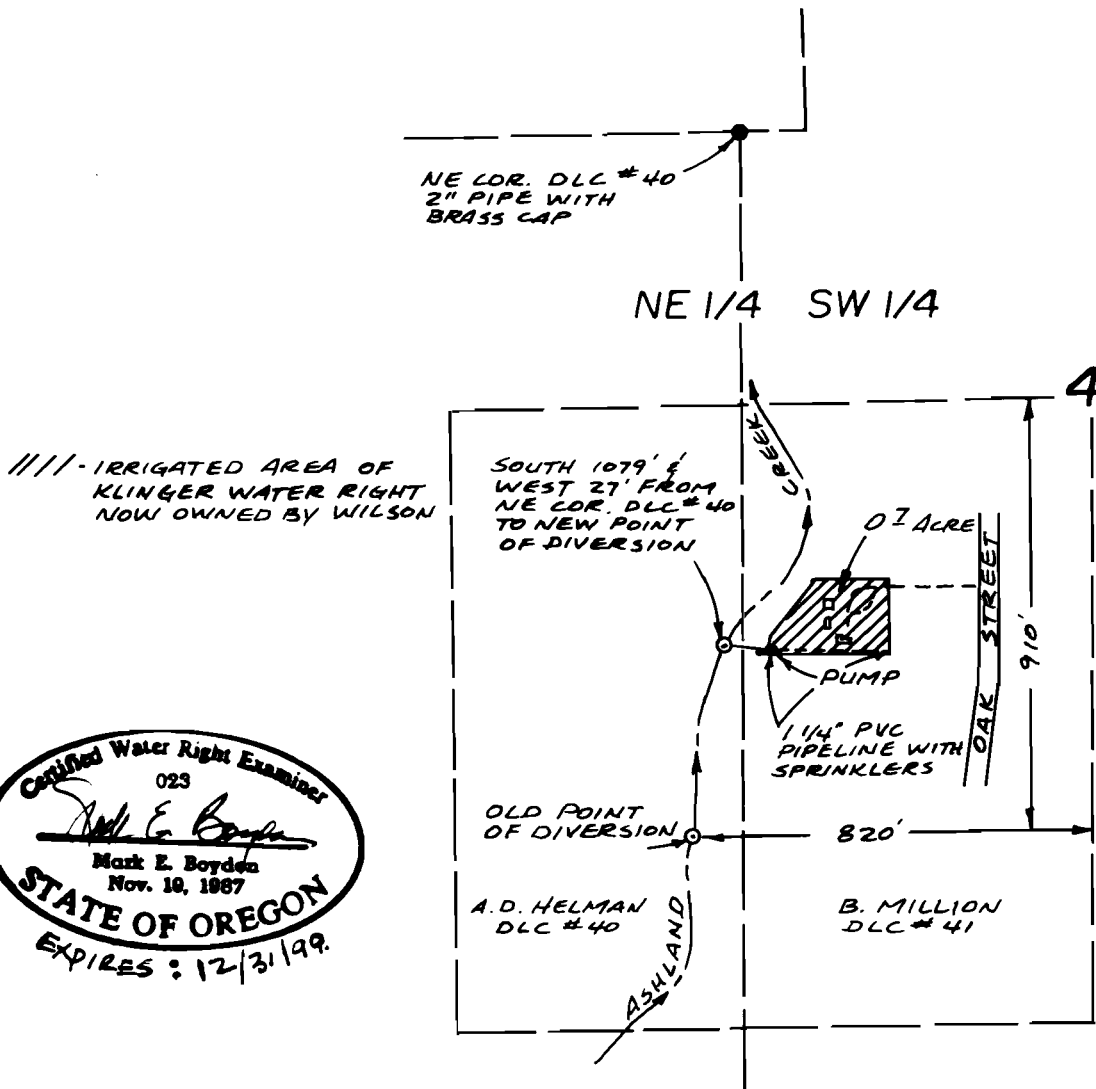

**TRANSFER APPLICATION MAP**

CERTIFICATE NO. T-7745

APPLICANT: DANIEL WILSON  
 777 OAK ST.  
 ASHLAND, OR. 97520



SCALE: 1" = 400'

NOTE: THIS MAP IS NOT TO BE UTILIZED FOR BOUNDARY SURVEYS