



**Claim of Beneficial Use
Eagle Point Golf Course
T36S, R1W, Sec 3 & 10**

T-8513

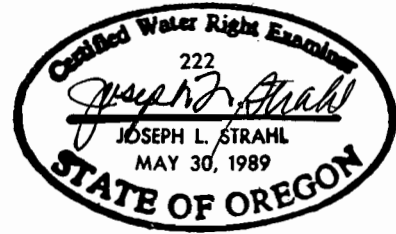


This map is not intended to provide legal dimensions or locations of property ownership lines.

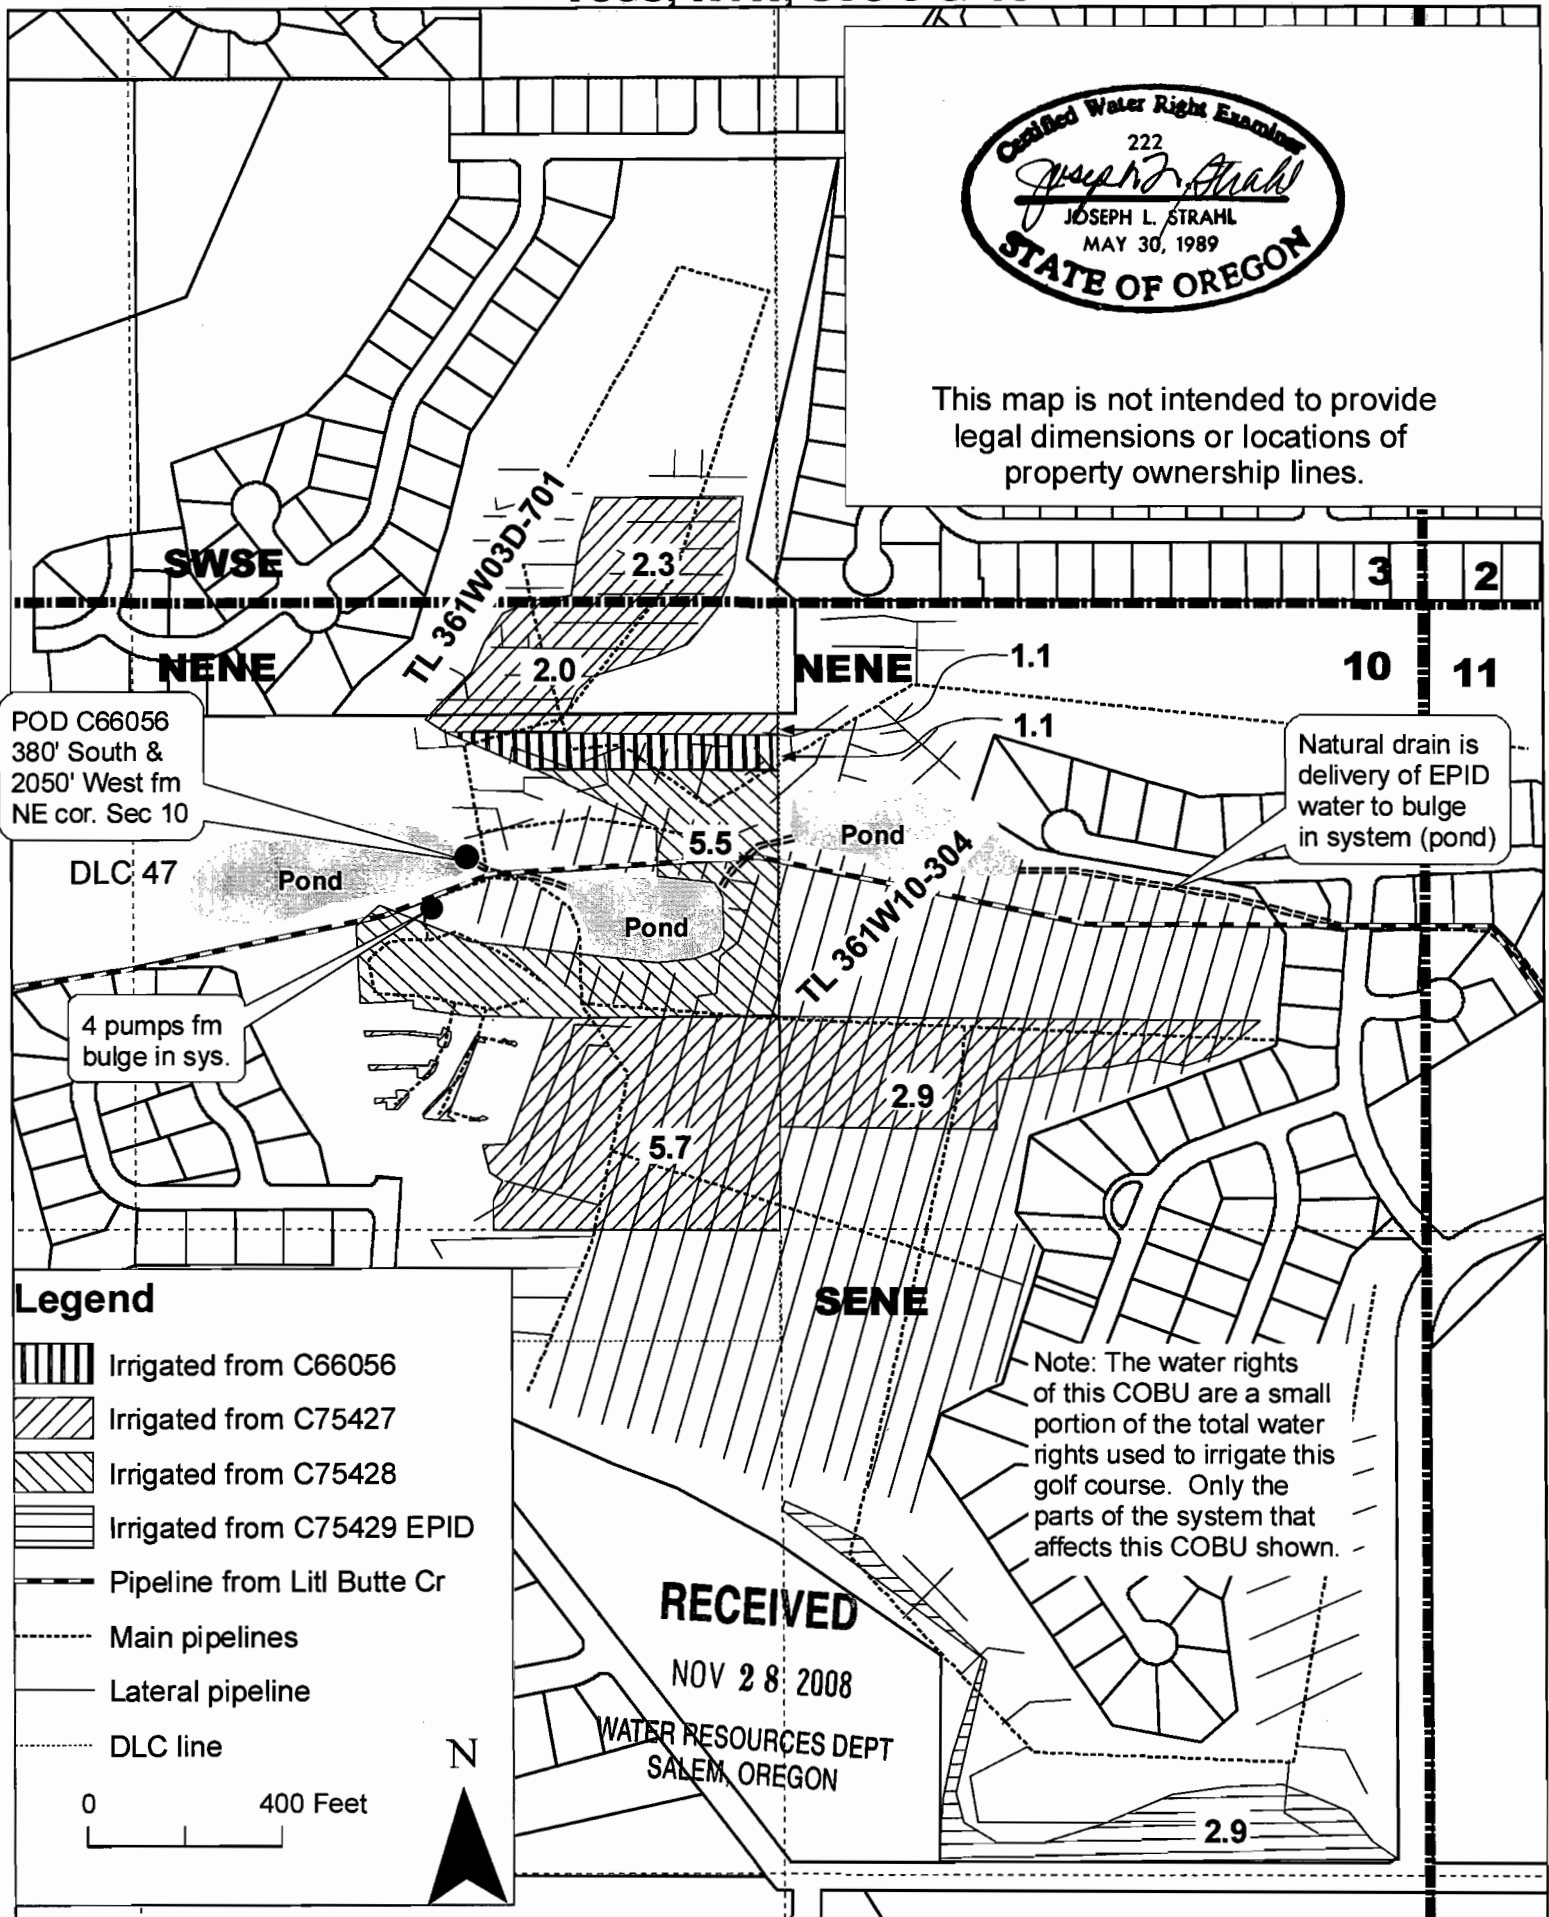


Legend

- Irrigated from C66056
- Irrigated from C75427
- Irrigated from C75428
- Irrigated from C75429 EPID
- Pipeline from Little Butte Cr
- Main pipelines
- Lateral pipeline
- DLC line

0 400 Feet

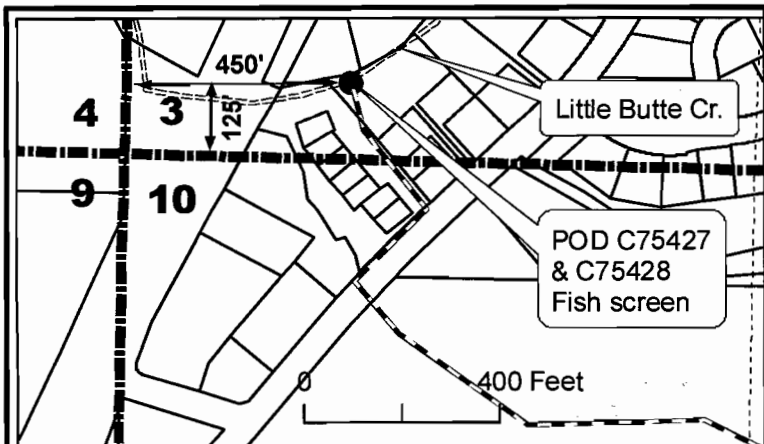

POD from Little Butte Creek

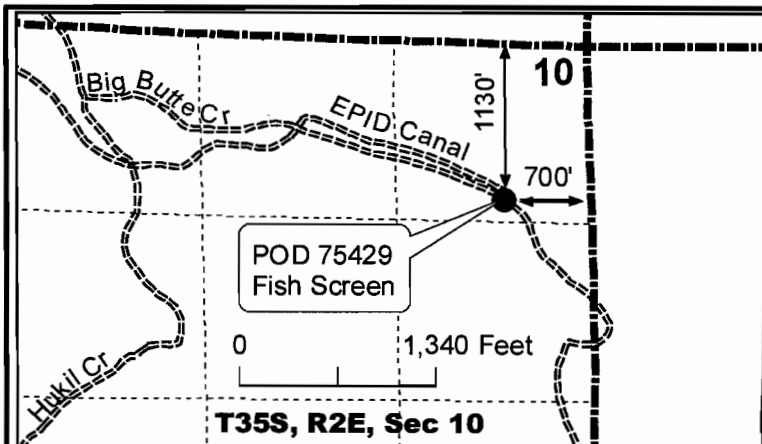

EPID POD