
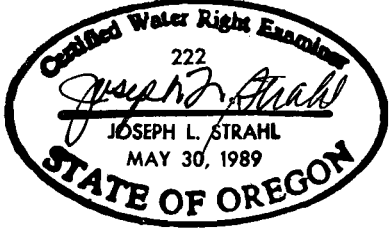


**Claim of Beneficial Use
Eagle Point Golf Course
T36S, R1W, Sec 3 & 10**

T-8513

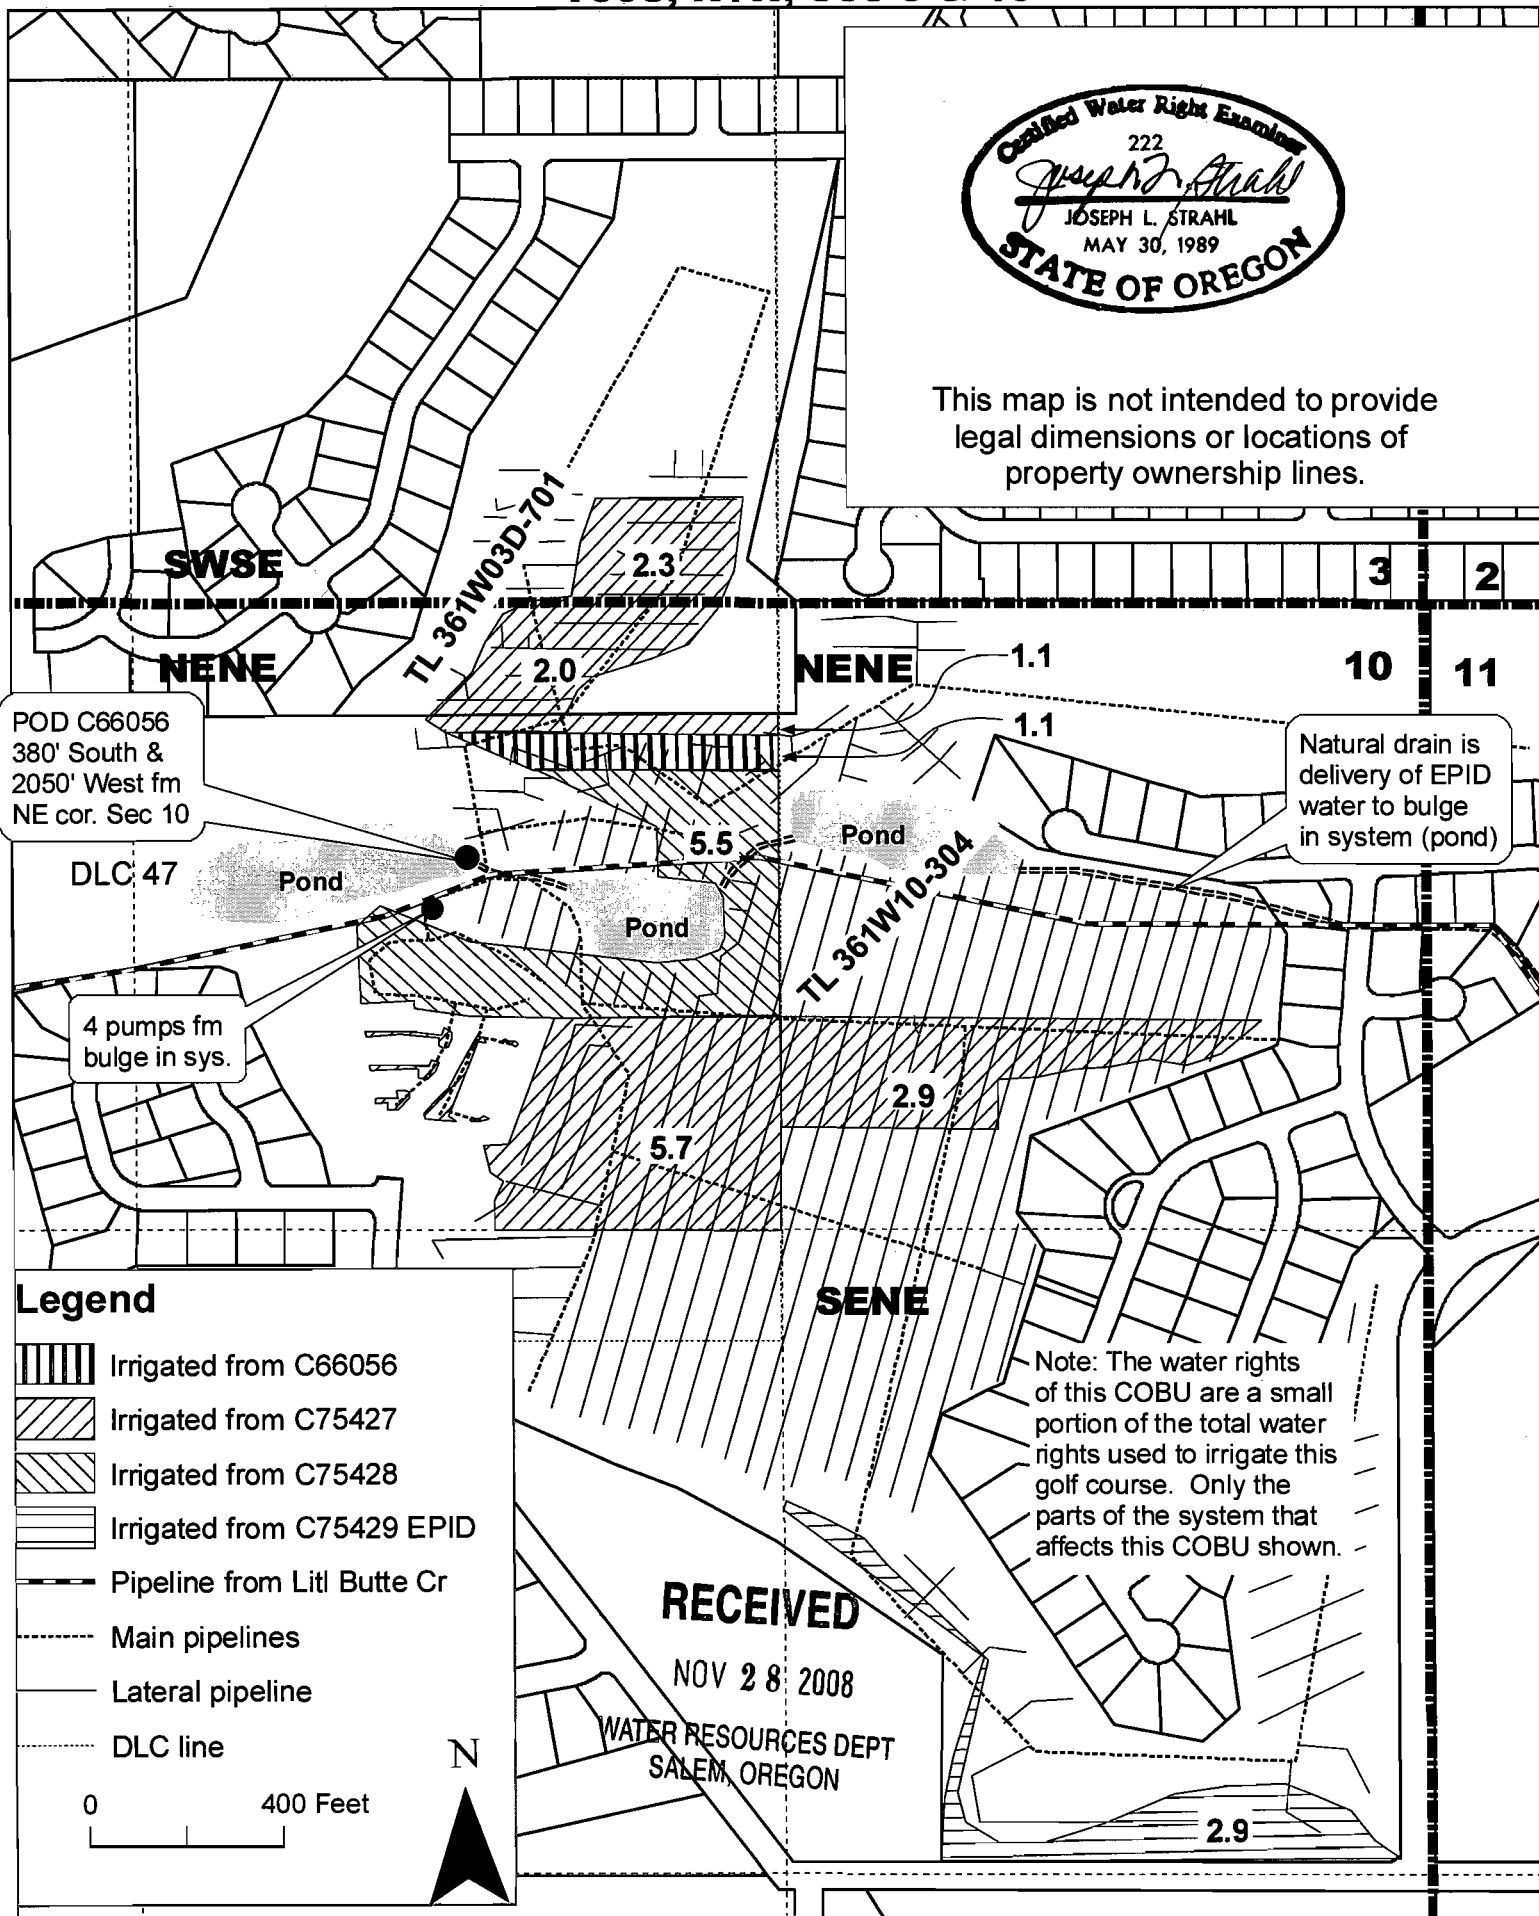

This map is not intended to provide legal dimensions or locations of property ownership lines.

POD C66056
380' South &
2050' West fm
NE cor. Sec 10

Natural drain is
delivery of EPID
water to bulge
in system (pond)

DLC 47

4 pumps fm
bulge in sys.

Legend

- Irrigated from C66056
- Irrigated from C75427
- Irrigated from C75428
- Irrigated from C75429 EPID
- Pipeline from Little Butte Cr
- Main pipelines
- Lateral pipeline
- DLC line

0 400 Feet

N

Note: The water rights of this COBU are a small portion of the total water rights used to irrigate this golf course. Only the parts of the system that affects this COBU shown.

RECEIVED

NOV 28 2008

WATER RESOURCES DEPT
SALEM, OREGON

