


# FINAL PROOF SURVEY MAP

IN THE NAME OF ROBERT & PHYLLIS PRICHARD

T 9 S, R 1 E, W.M.  
Section 22

T-10743

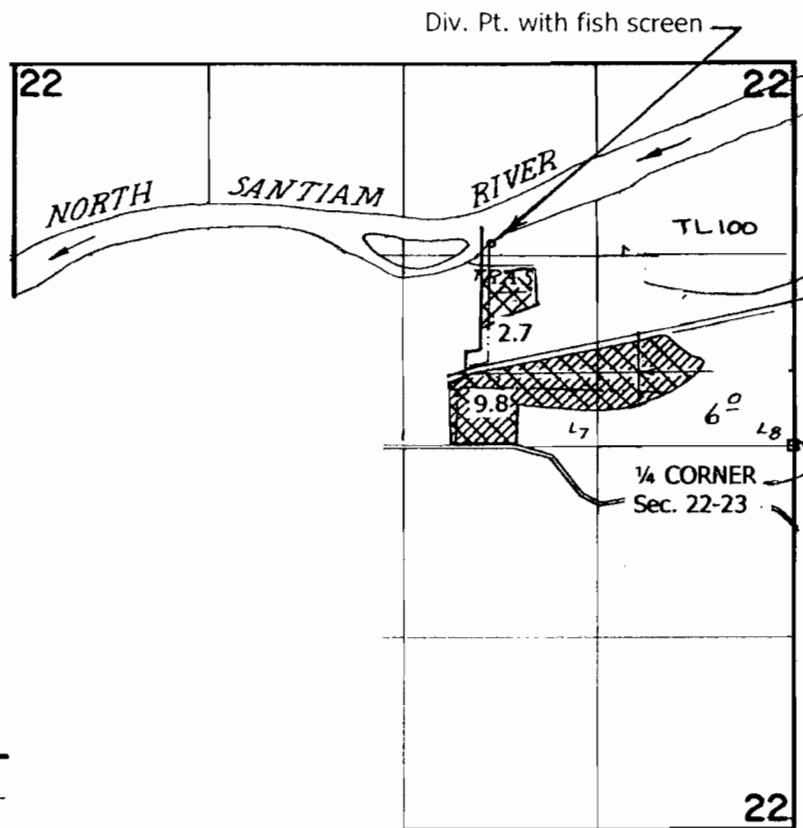


Section line:   
1/4 1/4 line:   
Pipe line:   
Gov. Lot line:



Lands irrigated by N. Santiam River Div. Pt.

North Santiam River Div. Pt.: 1420' N and 2050' W of the 1/4 corner section 22-23

Scale 1" = 1320'

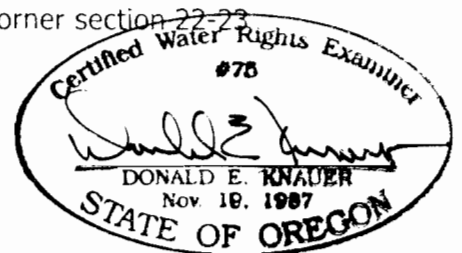

This map is not intended to provide legal dimensions or locations of property ownership lines.

RENEWAL DATE 6/30/2011