

T40S., R 11E., SEC.'S 32 & 33 W.M.


KLAMATH COUNTY, OREGON

TRANSFER APPLICATION 10316


CERTIFICATE 74895

PERMIT G-5457

JUL 29 2010

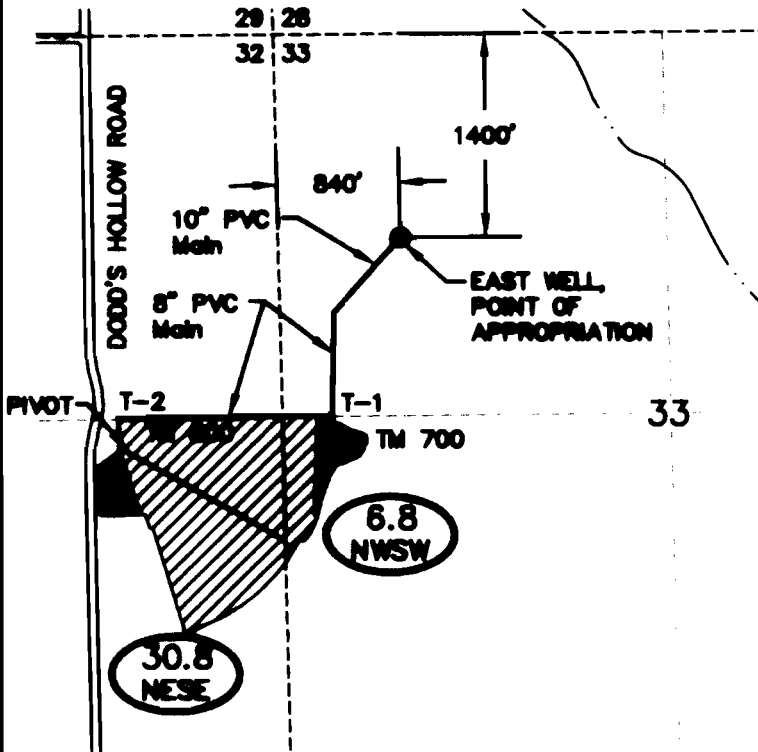

SCALE: 1" = 1320'

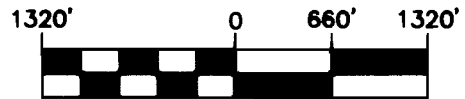

NOTES:


1. THIS MAP WAS PREPARED FROM FIELD MEASUREMENTS, NAIP 2005 AERIAL PHOTOGRAPH, KLAMATH COUNTY TAX MAPS AND KLAMATH COUNTY RECORD OF SURVEY 3455.

2. THE PURPOSE OF THIS MAP IS TO IDENTIFY THE LOCATION OF THE WATER RIGHT ONLY, AND IS NOT INTENDED TO PROVIDE DIMENSIONS OR LOCATION OF PROPERTY LINES.

TAX MAP #	1/4 1/4	SECTION	TOWNSHIP	RANGE	# IRRIGATED ACRES
800	NE SE	32	40S	R11E, WM	30.8
700	NW SW	32	40S	R11E, WM	6.8

TOTAL ACRES IRRIGATED: 37.6

LEGEND

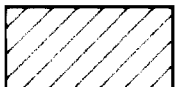

IRRIGATED LANDS THIS CLAIM OF BENEFICIAL USE



IRRIGATED ACREAGE

1/4 1/4 SECTION

TM800

TAX MAP NUMBER

32

SECTION CORNER

33

SECTION NUMBER AND CENTER OF SECTION

_____ DITCH LINE

DITCH LINE

_____ PIVOT LINE

PIVOT LINE

_____ MAIN LINE

MAIN LINE


_____ HAND LINE

HAND LINE

----- SECTION LINE

SECTION LINE

1/4 1/4 LINE

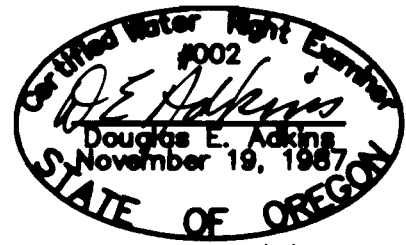

RENEWAL 1/1/11

[Signature]
Applicant signature

ADKINS
SINCE 1983

CONSULTING ENGINEERS, INC.

Engineers ▲ Planners ▲ Surveyors

2950 Sheeta Way · Klamath Falls, Oregon 97603 · (541) 884-4886 · FAX (541) 884-5335
Klamath Falls, OR · Medford, OR · Alturas, CA

6/21/10

Boas.dwg

2858-01

Claim of Beneficial Use Map

for

**DANIEL J. SHUCK
TAMMY A. SHUCK**

KLAMATH COUNTY, OREGON