

**CLAIM OF BENEFICIAL USE MAP  
FOR AN ADDITIONAL POINT OF DIVERSION**

**FOR  
LAWRENCE & NETTIE DOWNING  
LOCATED IN THE NE 1/4 OF THE NE 1/4  
OF SECTION 22, T. 14 S., R. 17 E., W.M.  
CROOK COUNTY, OREGON**

**TRANSFER APPLICATION T-10921**

**RECEIVED**

MAR 05 2012

WATER RESOURCES DEPT  
SALEM, OREGON



SCALE: 1" = 400'


DATE: 2-07-12

I, ROBERT E. BAXTER, CERTIFIED WATER  
RIGHT EXAMINER IN THE STATE OF OREGON,  
HEREBY CERTIFY THAT THIS WATER RIGHT  
SURVEY MAP WAS PREPARED BY ME.

THE PREPARATION OF THIS MAP IS FOR  
PURPOSE OF IDENTIFYING THE LOCATION OF  
THE WATER RIGHT ONLY AND HAS NO  
INTENT TO PROVIDE DIMENSIONS OR  
LOCATIONS OF PROPERTY OWNERSHIP LINES.

LEGEND

----- MAINLINE

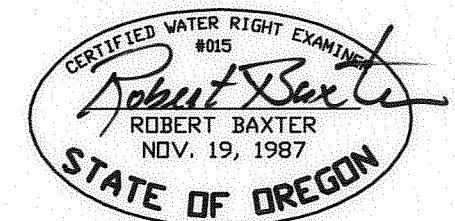

ORIGINAL P.O.D. LOCATION:  
1033 FEET NORTH AND 899 FEET WEST  
OF THE SOUTHEAST CORNER OF SECTION  
15, T. 14 S., R 17 E., W.M.

FISH SCREEN AND BYPASS INSTALLED BY ODFW  
620 FOOT - 24" BURIED PLASTIC PIPE

NEW P.O.D. LOCATION:  
350 FEET SOUTH AND 473 FEET WEST  
OF THE NORTHEAST CORNER OF SECTION  
22, T. 14 S., R 17 E., W.M.  
SERVING TAX LOTS 14-17-00-1800 & 1806  
FISH SCREEN INSTALLED ON PUMP INTAKE  
HOSE & METER INSTALLED ON OUTPUT PIPE

OPEN DITCH

925' LONG 4" BURIED MAINLINE PVC

400' (4") WHEELLINE

15 14

22 23

NW/NW

TAX LOT 14-17-1800  
NOTE: MILL CREEK IS TAX LOT LINE

3' HANDLINE

NE/NE  
POND & PUMPS

TAX LOT 14-17-1806

600 FOOT - 3" BURIED MAINLINE PVC

1200' (4") WHEELLINE

30.0

7.5

1100 FOOT - 3" MAINLINE ALUM. ABOVE GROUND

ALL NOZZLES ARE 9/64"  
29 NOZZLES ON LONG WHEELLINE  
10 NOZZLES ON SHORT WHEELLINE  
340 PCS OF HANDLINE.

980 FOOT - 3" MAINLINE ALUM. ABOVE GROUND

PREPARED BY: BAXTER LAND SURVEYING, INC.  
P.O. BOX 7022 BEND, ORE, 97708 (541) 382-1962

**COBU MAP # 0667**

0667