


RECEIVED

FEB 16 2012

WATER RESOURCES DEPT
SALEM, OREGON

T. 3S. R. 9E. W.M.
TAX LOT 190

6

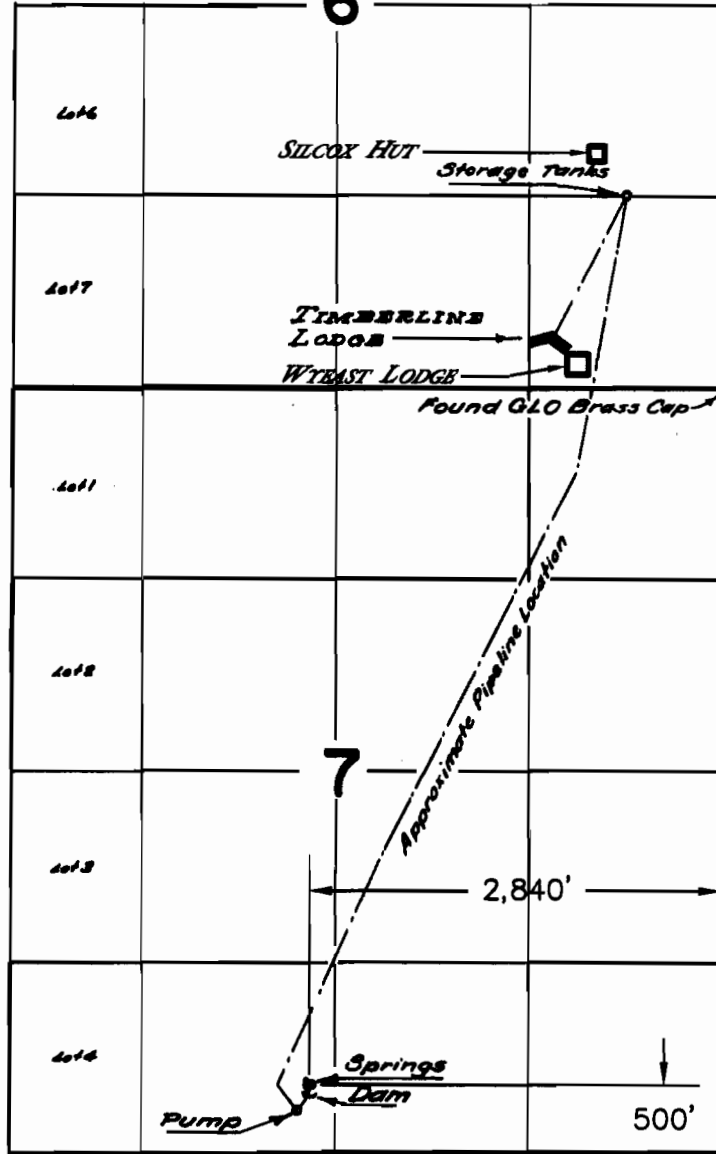

7

FINAL PROOF SURVEY

UNDER

C29948

TRANSFER APPLICATION No. T-11180

Application No. 32236 Permit No. REG37
IN NAME OF

U. S. FOREST SERVICE

Surveyed July 25 1961, by C. D. Bartels

DISCLAIMER

THIS MAP IS NOT
INTENDED TO PROVIDE
LEGAL DIMENSIONS OR
LOCATION OF PROPERTY
OWNERSHIP LINES



SCALE: 1" = 1320'