
# SECTION 35, T2N, R32E, WM **UMATILLA COUNTY**

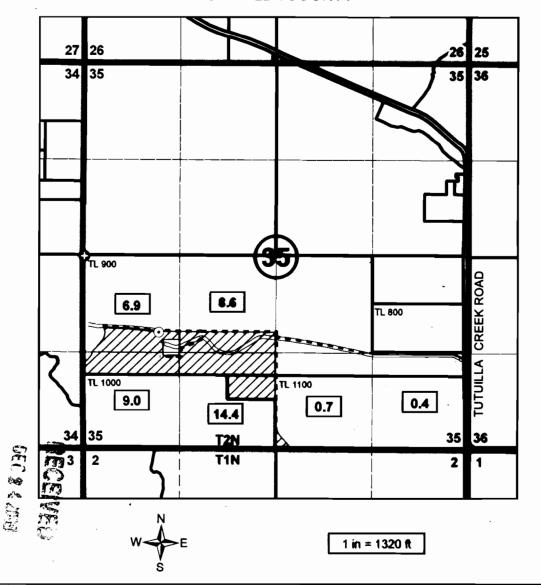

### Point of Appropriation (POA)

Groundwater well in basalt aquifer located in NW/4, SW/4, Section 35 at a distance 1040 feet S and 1047 ft E from W Quarter-Corner of Section 35. Well Log UMAT 55751. Flowmeter located in pump house 20 feet south of well.

#### Conveyance

Buried 3-inch mainline feeding riser valves/hydrants. Water applied to grass pasture with Nelson SR75 Big Guns mounted on two Kifco automated, hard-hose travelers.



# //// Place of Use

40.0 acres, including:

8.6 acres in the NE/SW of Section 35 (TL 900)

6.9 acres in the NW/SW of Section 35 (TL 900)

9.0 acres in the SW/SW of Section 35 (TL 900)

14.4 acres in the SE/SW of Section 35 (TL 900 + 1100)

0.7 acres in the SW/SE of Section 35 (TL 1100)

0.4 acres in the SE/SE of Section 35 (TL 1100)

Up to 0.5 acre of non-commercial lawn and garden in vicinity of home is irrigated as exempt domestic use.

The purpose of this map is to identify the location of a water right. It is not intended to provide information regarding the location of property ownership boundary lines.




Prepared By

**FOUNTAINHEAD** 1204 Alvarado Terrace Walla Walla, WA 99362 509.529.2646 phone

## **CLAIM OF BENEFICIAL USE** Transfer 10417

in the name of TOM & JUDITH KENNEDY

Revised 16 NOV 2009