

RECEIVED

FEB 1 1996

T.6S., R.1W., W.M.

RECEIVED


SEP 18 1995

WATER RESOURCES DEPT
SALEM, OREGON

RECEIVED

JAN 23 1996

WATER RESOURCES DEPT
SALEM, OREGON

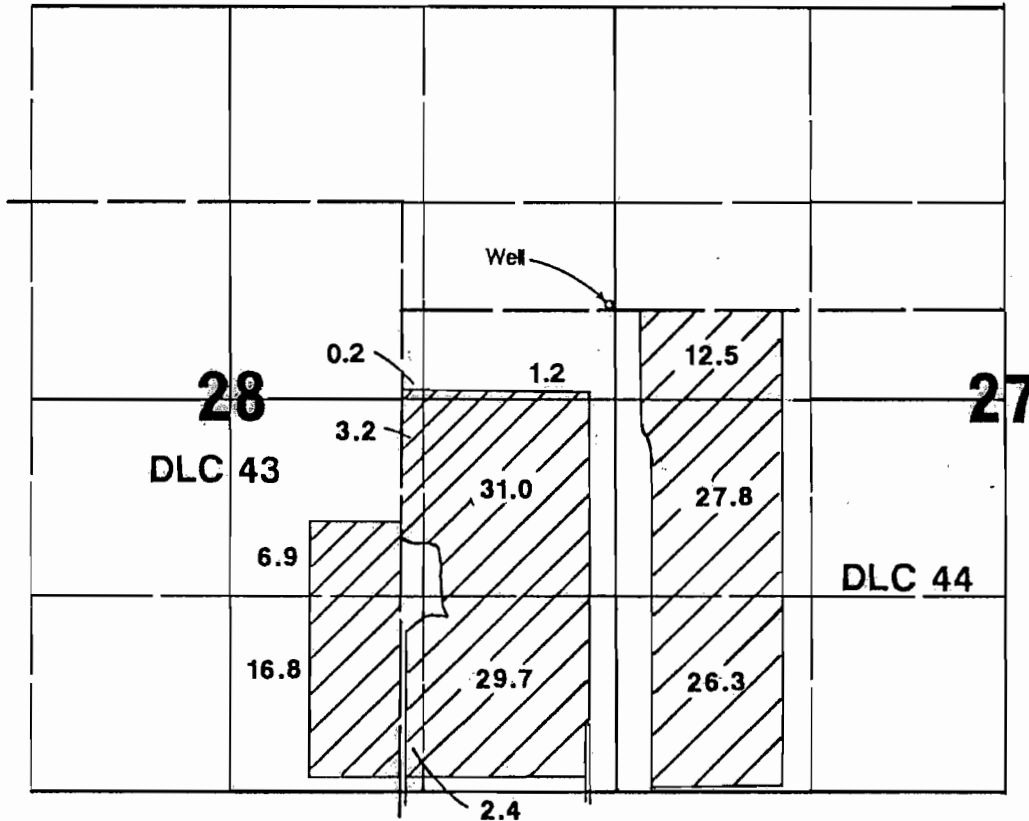

1" = 1320'



WELL LOCATED 1775'S $\frac{1}{2}$ 24' W FROM NE CORNER SECTION 28.


Final Proof Survey

Application #: G-12434 Permit #: G-11434

In Name Of

Robert E. Roth

Surveyed on May 20, 1995 by James Grimm

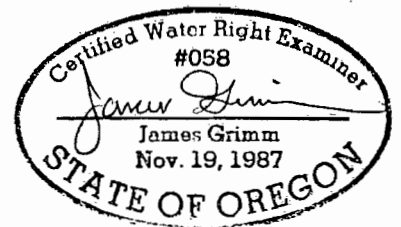

THIS MAP WAS PREPARED FOR THE PURPOSE OF IDENTIFYING THE LOCATION OF A WATER RIGHT ONLY AND IS NOT INTENDED TO PROVIDE LEGAL DIMENSIONS OR LOCATION OF PROPERTY OWNERSHIP LINES.