
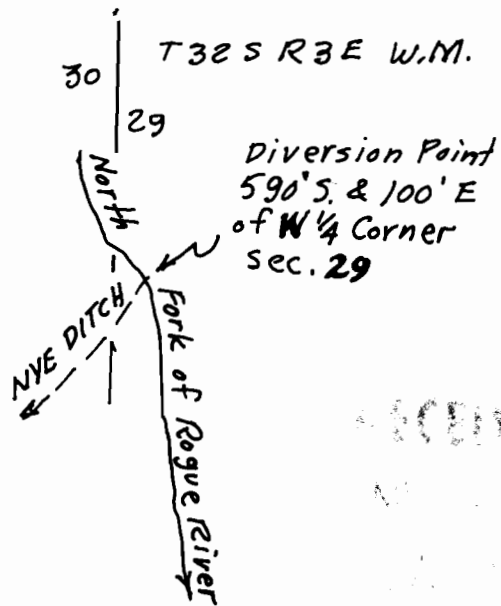


T33S R2E WM Final Proof Survey under

Application No. 69490
Permit No. 50242
in the name of
Stuart O. and Linda M. Carrico

Surveyed Oct. 16, 1992
By. Robert Joseph Milts
WRE 090

The purpose of this map is to identify the location of a water right and is not intended to provide legal dimensions for locations of property boundaries.

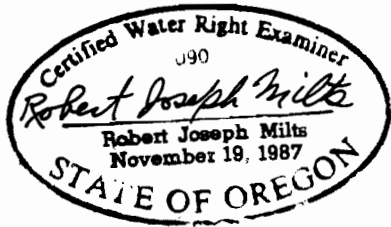

RECEIVED
MAY 1993

