

**● Authorized POA**

Groundwater well in basalt aquifer located 886 feet N and 1032 ft W from Center of Section 3 in the SE/4, NW/4, Section 3 (flowmeter located immediately to north in same location)


**----- Conveyance**

6-inch buried mainline feeding zone control valves, submains and irrigation laterals (1-inch LDPE feeding overhead Nelson R2000 sprinklers, and 0.5-inch LDPE drip tubing)

**▨ Place of Use**

22.0 acres located in SE/4, NW/4, Sec 3 including wine grapes, cover crops, herbs, lawn and landscape (less pond, house and roads)

The purpose of this map is to identify the location of a water right. It is not intended to provide information regarding the location of property ownership boundary lines.

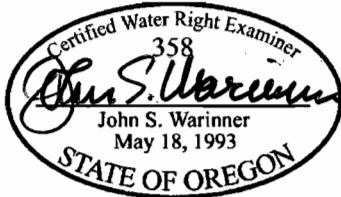

**FOUNTAINHEAD**  
1860 Blue Creek Road  
Walla Walla, WA 99362  
509.529.2646 phone

**FINAL PROOF SURVEY  
Transfer 9847**

in the name of  
**KEN HARRISON**

Revised 31 DEC 2006