
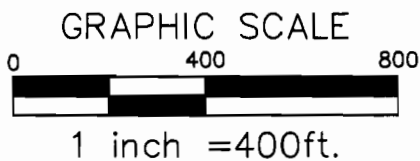


CLAIM OF BENEFICIAL USE MAP

NW 1/4 OF SECTION 2, T3S, R2W, WM
LOT 400 OF TAX MAP T3S R2W SECTION 2
WASHINGTON COUNTY, OREGON
WILLAMETTE RIVER BASIN
TRANSFER APPLICATION T-10461

PREPARED FOR:
HUGH AND JANET WEBER
21750 SW CHAPMAN ROAD
SHERWOOD OREGON, 97140

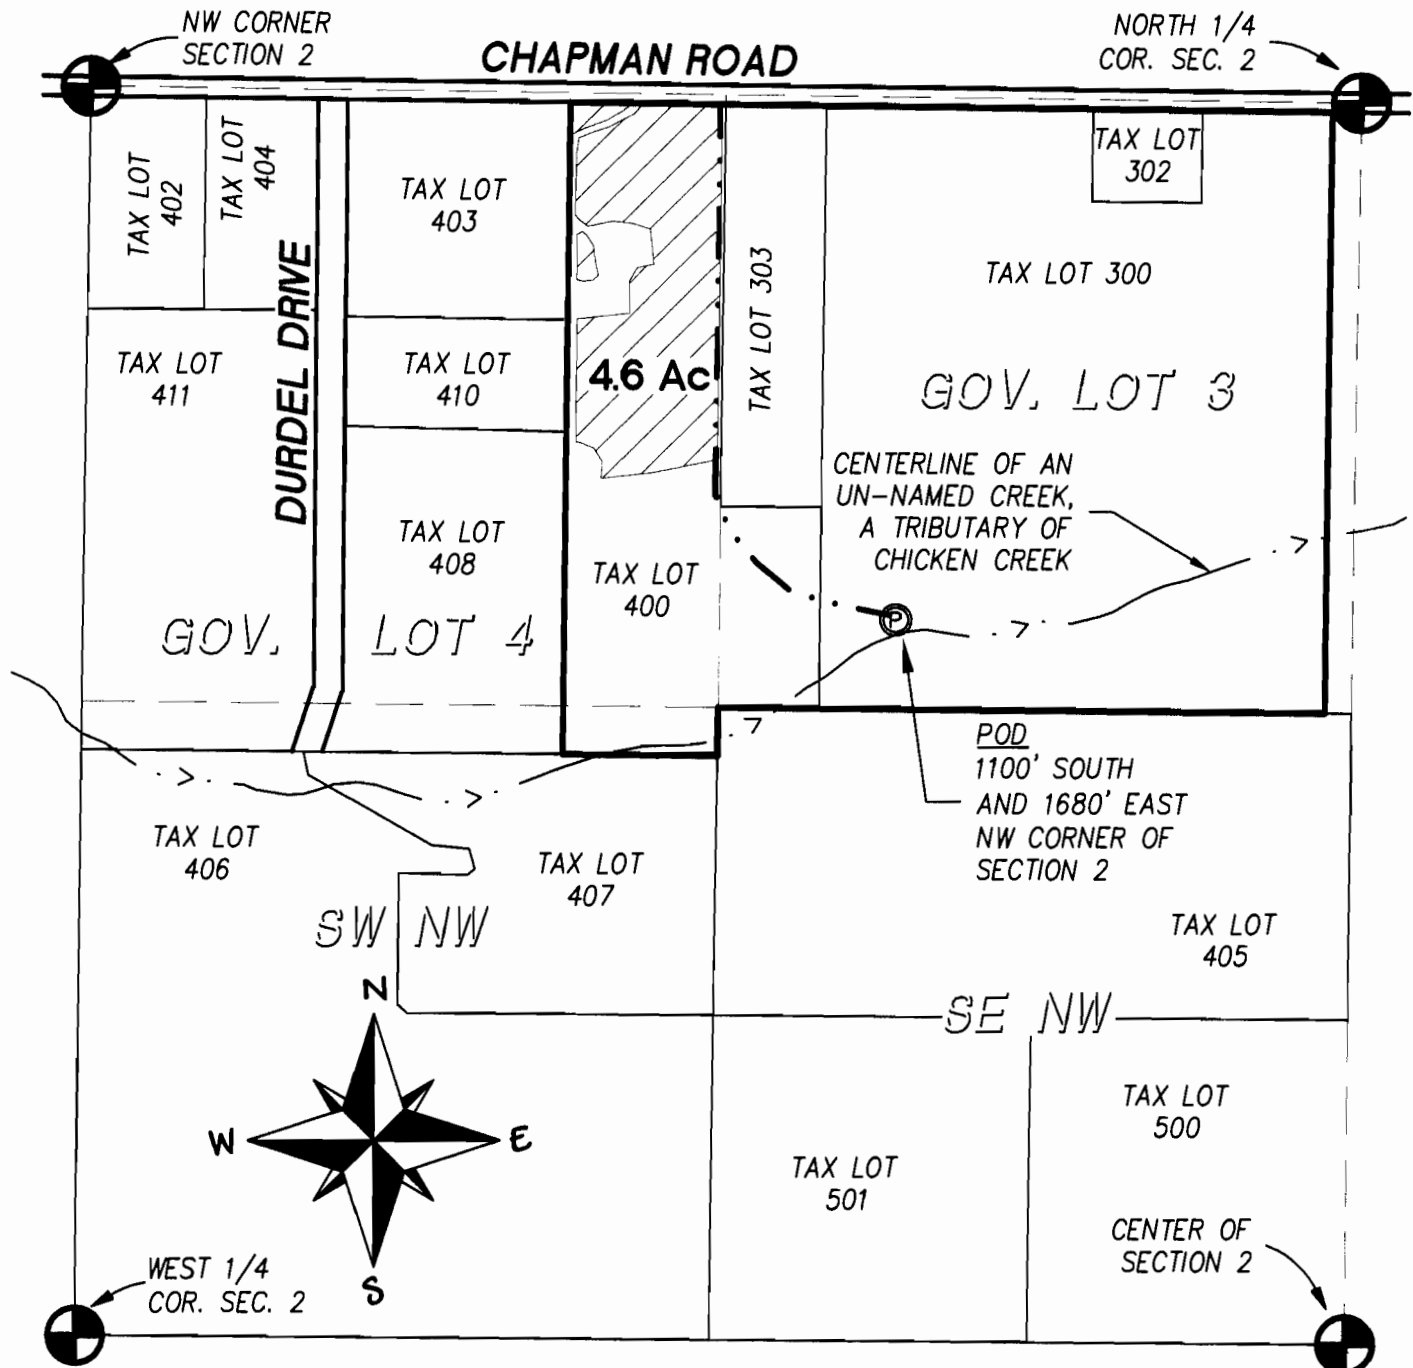

LEGEND

- POD - LOCATED 1100' SOUTH AND 1680' EAST OF THE NORTHWEST CORNER OF SECTION 2
- TRANSFER T-10461 IRRIGATED AREAS
- TYPICAL LOCATION OF PORTABLE IRRIGATION PIPELINE
- PROPERTY LINE
- TAX LOT LINE
- SECTION AND QUARTER SECTION LINES

MAP BASES: WASHINGTON COUNTY TAX MAP 3S2 2
2010 GOOGLE EARTH AERIAL PHOTO

THIS MAP WAS PREPARED FOR THE PURPOSE OF IDENTIFYING THE LOCATION OF A WATER RIGHT ONLY AND IS NOT INTENDED TO PROVIDE LEGAL DIMENSIONS OR LOCATION OF PROPERTY OWNERSHIP LINES.

RECEIVED

DEC 06 2010

WATER RESOURCES DEPT
SALEM, OREGON



Stuntzner

Engineering
& Forestry, LLC

PROJECT: 307-2-071
BY: Kaid E. McKay
CHECKED BY: EAU
DATE: NOVEMBER 17, 2010