

SURVEY FOR CLAIM FOR BENEFICIAL TRANSFER T-6724  
SECTION 29, T28S, R4W, WM


RECEIVED

SEP 28 2000

WATER RESOURCES DEPT.  
SALEM, OREGON

BASED ON SURVEY  
OF NE 1/4 OF SECTION  
PER SURVEY M124-53

THIS MAP IS TO BE USED FOR WATER RIGHT PURPOSES ONLY

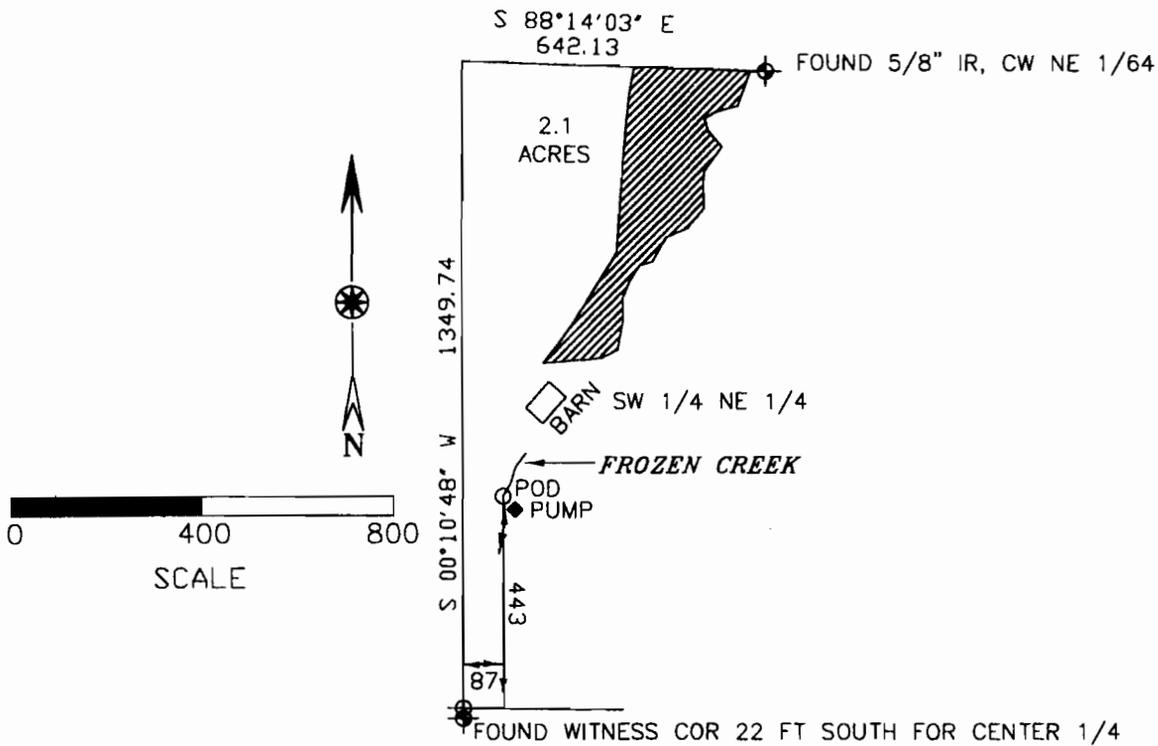

IN NAME OF  
*Dennis Jacobs*

EXPIRES 12-31-00

SEPT. 22, 2000

WILLIAM J. RUPPERT  
P.O. BOX 1564  
MYRTLE CREEK, OR 97457

