

5" MAINLINE ALONG NORTH BOUNDARY  
FEEDS 3" HAND SPRINKLER LINES

PUMP LOCATED AT EDGE OF POND  
DIVERSION IS S85°25'24"E - 1176.61 FEET  
FROM THE NORTHWEST SECTION CORNER OF  
SECTION 23

PUMP LOCATED A POINT OF DIVERSION  
AT POND  
PUMP IS 5 HORSEPOWER CENTURY PUMP  
WITH A 5 " DISCHARGE  
SERIAL NUMBER 6-357577-12-00  
PUMP DISCHARGE CONTROLLED BY VALVE TO  
SERVICE WHEEL LINE OR HAND LINE

BURIED 6" MAINLINE WITH 4" RISERS  
FEEDS 5" DIAMETER WHEEL  
LINE  
FOR EAST AREA

TOTAL AREA IRRIGATED 30.71 ACRES


MAP TO ACCOMPANY CLAIM OF BENEFICIAL USE  
FOR  
TRANSFER T-8539  
LOCATED IN THE  
NW 1/4 OF SECTION 23  
TOWNSHIP 39 SOUTH, RANGE 19 EAST W. M.  
LAKE COUNTY, OREGON

NOTE:  
PREPARATION OF THIS MAP IS FOR IDENTIFYING PROPOSED  
WATER RIGHTS ONLY. IT HAS NO INTENT TO PROVIDE LOCATIONS  
OR DIMENSIONS OF PROPERTY LINES.

RECEIVED  
OCT 21 2002  
WATER RESOURCES DEPT.  
SALEM, OREGON



SCALE: 1" = 1320'

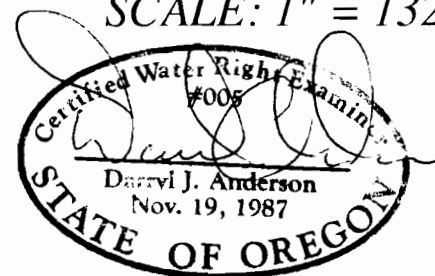

Renew 12/31/03

ANDERSON ENGINEERING  
AND SURVEYING, INC.

P.O. BOX 28  
LAKEVIEW, OREGON 97630  
(541) 947-4407  
FAX 947-2321

P.O. BOX 419  
REDMOND, OREGON 97756  
(541) 923-4307  
FAX 923-4308

PREPARED FOR:  
SAM AND CONNIE START

P.O. BOX 111  
LAKEVIEW, OREGON 97630  
(541) 947-2396

DATE: 8/2002  
SCALE: SHOWN  
JOB: 2000-41  
DWG. BY: DJA  
FILE: 2002-41  
SHEET 1 OF 1