T.13S., R.26E.

RECEIVED
WATER RESOURCES DEPT
SALEM, OREGON

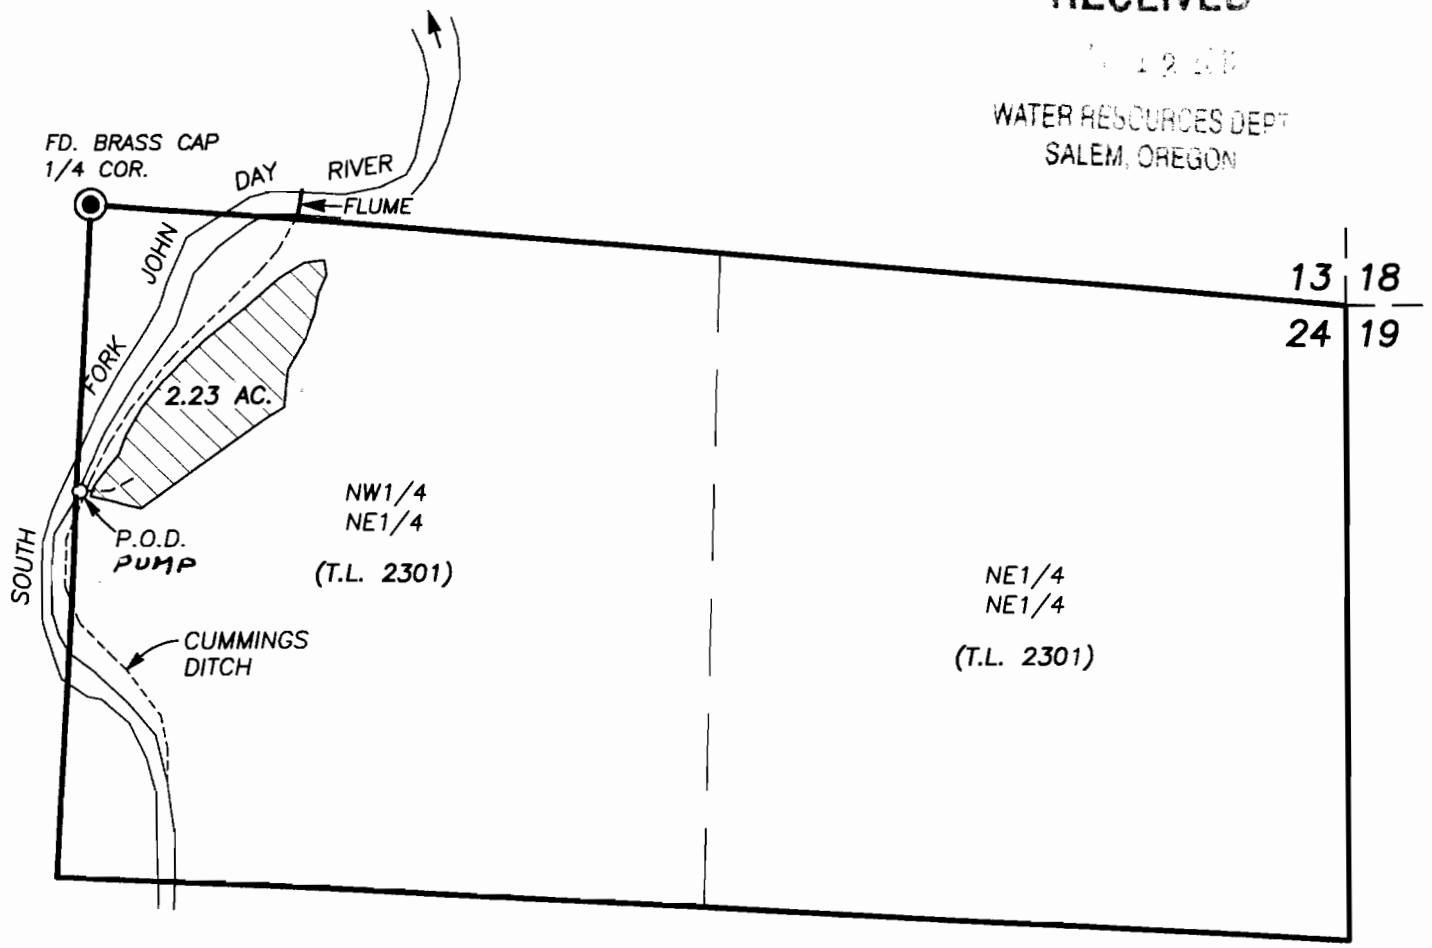

P.O.D. AND FISH SCREEN IS 600' SOUTH & 25' WEST OF THE N1/4 CORNER SECTION 24, T.13S., R.26E., W.M.
IN LINE FLOW METER IS 125 FT. NORTHEASTERLY OF P.O.D.

N

SCALE: 1" = 400'

FINAL PROOF SURVEY
UNDER
APPLICATION NO. T-10749
PERMIT NO. SPECIAL ORDER VOL. 80, PAGE 731

IN NAME OF
JAMES RIXEN

PLACE OF USE

( ) TAX LOT NO.

---- MAINLINE

NOTE:
THE LINES OF THE NW1/4NE1/4 AND NE1/4NE1/4 ARE AS SHOWN BY GRANT COUNTY RECORD MAP OF SURVEY NO. 1893, DATED 6/24/2010

NOTE: THE PREPARATION OF THIS MAP WAS FOR THE PURPOSE OF IDENTIFYING THE LOCATION OF THE PROPOSED WATER RIGHT AND HAS NO INTENT TO PROVIDE DIMENSIONS OR LOCATION OF PROPERTY OWNERSHIP LINES.

PREPARED BY:

ROBERT D. BAGETT
217 N. CANYON BLVD.
JOHN DAY, OREGON 97845
(541) 575-1251

AUGUST 4, 2011

Certified Water Right Examiner
009
Robert D. Bagett
Robert D. Bagett
Nov.19, 1987
STATE OF OREGON