
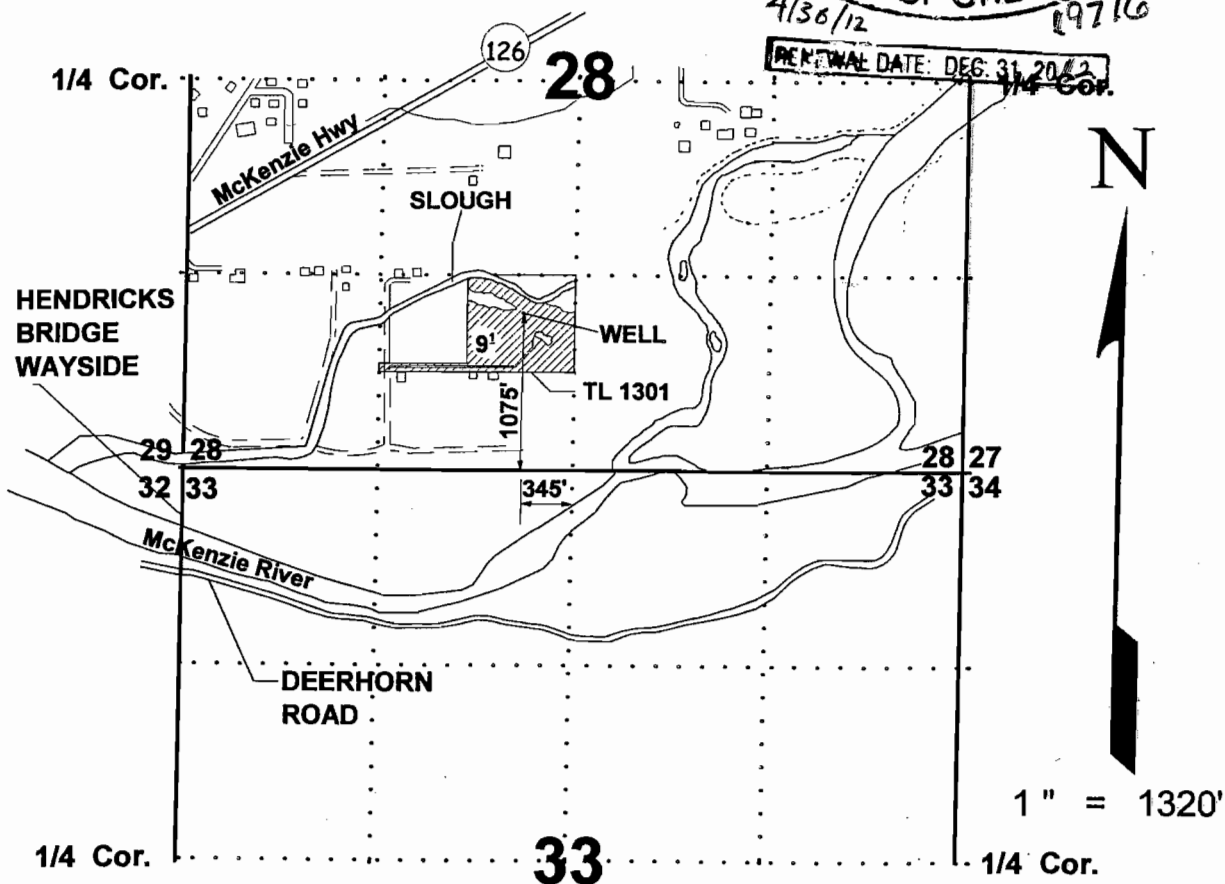


T.17S.,R.1W.,W.M.

SE1/4, SW1/4, SECTION 28

THE PURPOSE OF THIS MAP IS TO IDENTIFY THE LOCATION OF THE WATER RIGHT. IT IS NOT INTENDED TO PROVIDE LEGAL DIMENSIONS OR LOCATIONS OF PROPERTY OWNERSHIP LINES

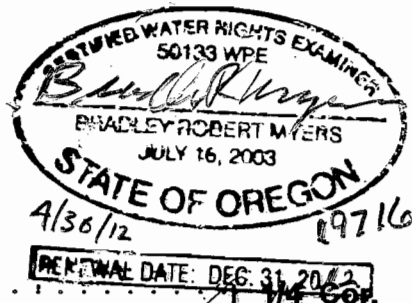

THE WELL IS LOCATED 1075' NORTH AND 345' WEST OF THE S.E. CORNER OF THE SW 1 / 4 OF SEC. 28.

FINAL PROOF MAP

Certificate 83680 Application No. T-8623 Permit No. S-52815

IN THE NAME OF
ROBERT GORDON

WATER RESOURCES DIVISION
SALEM, OREGON