
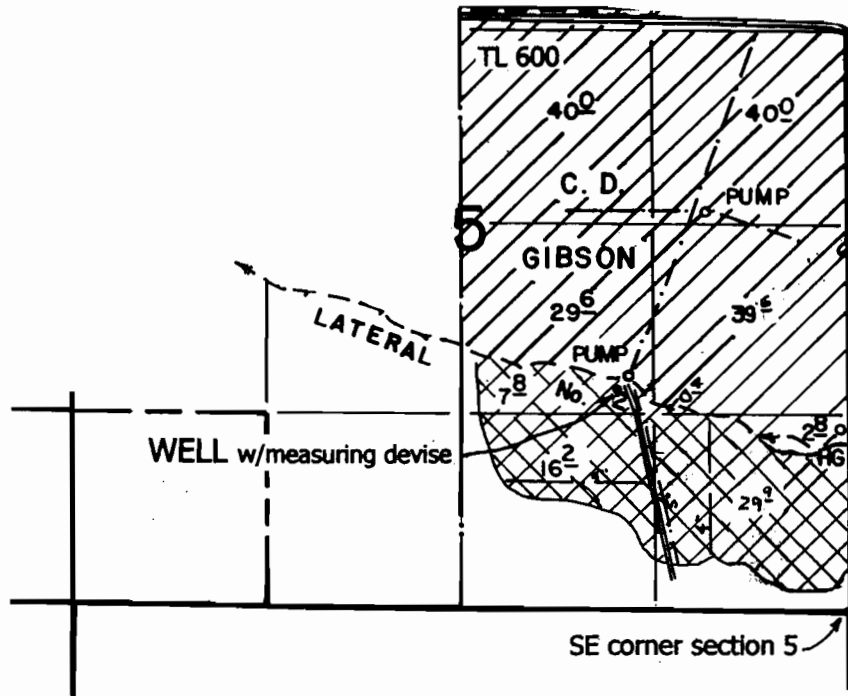


# FINAL PROOF SURVEY MAP

<sup>02</sup>  
CARL & RHOADEEN GIBSON

Application # G-12772 Permit # G-12448

T 40 S, R 13 W, W.M. Section 5  
<sub>E  
922</sub>

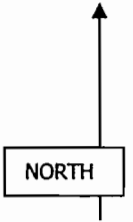


Supplemental Irrigation



Irrigation

Well: 1500' N & 1560' W  
from the SE corner Section 5

Scale 1" = 1320'

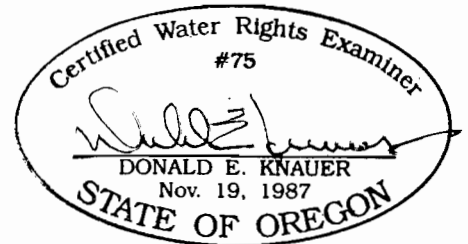

This map is not intended to provide legal dimensions or locations of property ownership lines .

RENEWAL DATE: 6-30-2009